


Section 10 Township 19 Range 10W

Well No. #1 Benhke

Company Virginia Drlg. et al

NORTH

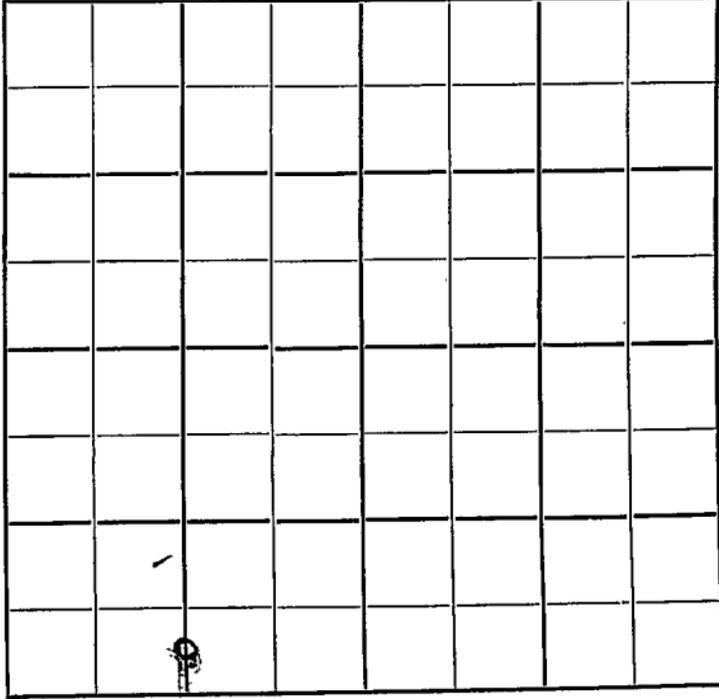

SOUTH

Sec. 10 Twp. 19 R. 10-W ✓

Well No. #1 Benhke Farm

Virginia Drlg. et al Company

Silicia Contractor


Ft. from N. Line

330 Ft. from S. Line

Ft. from E. Line

1320 Ft. from W. Line

C S/2 S/2 SW

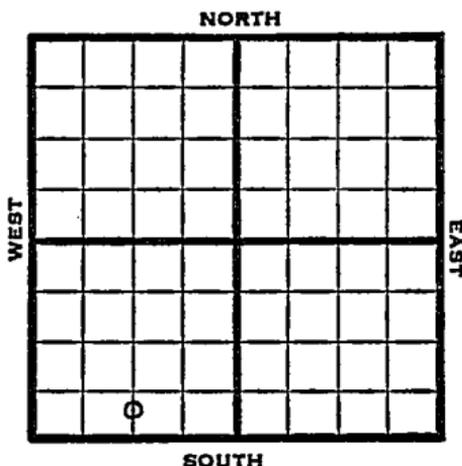

1950

Elev 1757

REPORT

6/7 Spud 6-4-50
8 5/8 @ 183
W.O.C.

6/21 TD 3344
8 5/8" @ 183

Heeb 2832

Br line 2958

Lans 2985

DST 3158-3208 opn 35 min rec 20 vsocm

Cong 3298

Arb 3324-44

DST 3323-44 opn 1 hr rec 75& mud

D&A

ABANDONED

Kansas Silicia

Map No. _____ Sec. 10 Twp. 19 R. 10W

Well No. 1 Benhke

Virginia Drlg. et al Company

Contractor

C S/2 S/2 SW

SECTION PLAT

_____ Ft. from N. Line

330

_____ Ft. from S. Line

_____ Ft. from E. Line

1320 _____ Ft. from W. Line



Rice

Location _____

Rig up _____

Drilling and Remarks:

Spud 6-4-50

8 5/8 C 183

W. O. C.

RECORD

Cased _____ in., _____ ft.

Sand _____

Gas _____

Oil _____

Total Depth _____

PRODUCTION

1st 24 hrs. Nat. _____

1st 24 hrs. after shot _____

Gas _____ Cu. Ft.

Dry Hole _____


Abandoned _____

Date

JUN 6 1950 19

J. E. TYRA Scout

Scout 1 100 100 0

 

Scout 1 100 100 0

JUN 12 1958

- Scout Cards
- Land Small Map
- Land Wall Map
- Tracings
- France Map
- Pierce Map
- Misc.

Map No. _____ Sec. 10 Twp. 19 R. 10W

Well No. 1 Benhke

Virginia Drlg. etal. Company

Contractor


C S $\frac{1}{2}$ S $\frac{1}{2}$ SWEl. 1757
SECTION PLAT

_____ Ft. from N. Line

330 Ft. from S. Line

_____ Ft. from E. Line

1320 Ft. from W. Line

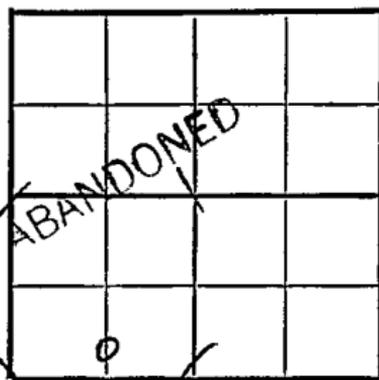

Rice County

Location _____

Rig up _____

Drilling and Remarks:

8 5/8" @ 183

Heeb. 2832

Br. line 2958

Lans. 2985

DST° 3158-3208

open 35 min.

Rec. 20 vsocm

RECORD

Cased _____ in., _____ ft.

Sand _____

Gas _____

Oil _____

Total Depth 3344

PRODUCTION

1st 24 hrs. Nat. _____

1st 24 hrs. after shot _____

Gas _____ Cu. Ft.

Dry Hole _____

Abandoned _____

Date

JUN 21 1950

19

J. E. TYRA Scout

1950 JUN 29



1. Scout Cards
 2. Land Small Map
 3. Land Wall Map
 4. Tracings
 5. France Map
 6. Pierce Map
 7. Misc.

05616 JUN 29 1950

- Scout Cards
- Land Small Map
- Land Wall Map
- Tracings
- France Map
- Pierce Map
- Misc.

D & A
 Rec. 751-mud
 open 1 hour.
 DST 3223-44
 Arb. 3224-44
 Cong. 3298