


Rice

Map No. **KANSAS** Sec. *10* Twp. *19* R. *10^W*
 Well No. *1 Brandenstein* Farm
Atlantic et al Company

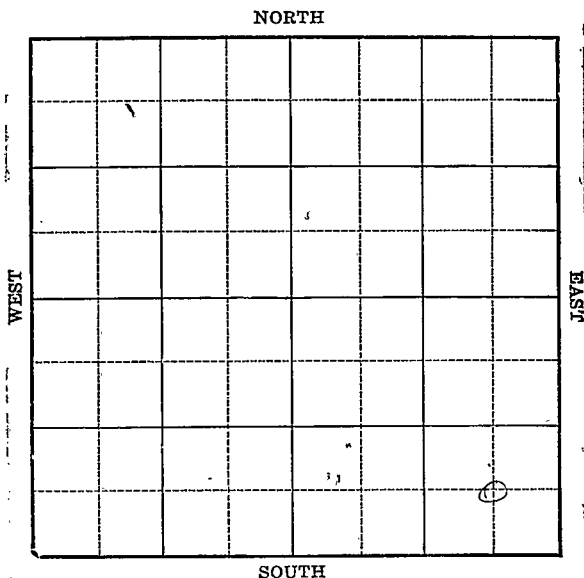

Location

Drilling Remarks

Rig Up

Drilling Remarks

RECORD

Cased _____ in. _____ ft.

Sand _____

Gas _____

Oil _____

Total Depth _____

PRODUCTION

1st 24 hrs. Nat. _____

1st 24 hrs. after shot _____

Gas _____ cu. ft.

Dry Hole _____

Abandoned _____

Rice


Map No. **KANSAS** Sec. 10 Twp 19 R. 10W
Well No. 1-Brandenstein Farm
Atlantic et al Company

 Ft. from N. Line

660 Ft. from S. Line

660 Ft. from E. Line

 Ft. from W. Line

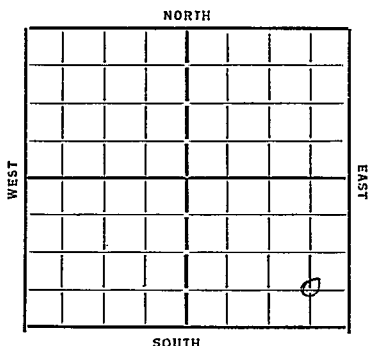

Date 1933

REPORT

8/30 location

9/6 cellar

9/13 Building rig

9/20 Rig up

9/29

10/0

10/11 hdrg 360

10/18 " 890

10/25 hdrg 1400 12" at 1270

11/1 " 1775 12" " 1612

11/8 " 2390 10 " 2147

11/15 " 2470 10" " 2414

11/22 Set 8" at 2940 - C.O.

11/29 K.C. Line 2936

1st oil 3014 T.D. 3026

flow 420 bbls 6 hrs

41st gravity 3 to 5 ft Gas

12/6 No test

12/12 flow 1093 bbls 24 hrs may deepen

12/26 K.C. Line 2936 - 3026

1093 bbls

COMPLETED

(over)

1934 O.W.D.D.

1/3- Drilling Deepen

1/11- Drilled to 3044- flowed
332 bbls in 3 hrs.

1/17 Flow 970 bbls 10 hrs
cutting 2%

1/24 — 1/31 — 2/9 —

2/14- TD 3044 flow 970 Bbls
10 hrs.

COMPLETED

Map No. 46 Sec. 10 Twp. 19 R. 10W

Well No. 1-Brandenstein

Atlantic Company

Contractor

SECTION PLAT

COMPLETED

660 Ft. from N. Line

660 Ft. from S. Line

660 Ft. from E. Line

 Ft. from W. Line

			0

Location

Rig up

Drilling and Remarks:

1093
flow

RECORD

Cased in., ft.
 Sand K. C. Line 2936
 Gas
 Oil
 Total Depth 3026

PRODUCTION

1st 24 hrs. Nat.
 1st 24 hrs. after shot
 Gas Cu. Ft.
 Dry Hole
 Abandoned

Date

12-20-33 192 O. Manschuet Scout

Handwritten scribbles and a large diagonal line across the page.

Returned	
Cards	<i>MB</i>
Tr	<i>MB</i>
France Map	<i>X</i>
Scarborough Map	<i>X</i>
Moody Map	<i>X</i>
Scarborough Flat Book	
Moody Flat Book	

Map No. 46 Sec. 10 Twp. 19 R. 10W

Well No. 1-Brandenstein

Atlantic Oilprod Company

Contractor

FIRST REPORTS

Ft. from N. Line

660 Ft. from S. Line

660 Ft. from E. Line

Ft. from W. Line

OWP 10

SECTION PLAT

Location

Rig up

Drilling and Remarks:

OTU 3026

Deepened 3044'

flow 332
bbls 3 hrs.

RECORD

Cased in., ft.

Sand

Gas

Oil

Total Depth

PRODUCTION

1st 24 hrs. Nat.

1st 24 hrs. after shot

Gas Cu. Ft.

Dry Hole

Abandoned

Date

1-3-34

192

O. W. Manscheck
Scout

not in files

Returned	☒
Cards	☒
Tracing	☒
France Map	☒
Scarborough Map	☒
History Map	☒
Scarborough Hist Book	☒
History Hist Book	☒

Map No. 46 Sec. 10 Twp. 19 R. 10W

Well No. 1-Brandenstein
Atlantic et al Company

Contractor

FIRST REPORTS

SECTION PLAT

			0

660 Ft. from N. Line

660 Ft. from S. Line

660 Ft. from E. Line

..... Ft. from W. Line

Location.....

Rig up.....

Drilling and Remarks:

RECORD

Cased..... in., ft.

Sand.....

Gas.....

Oil.....

Total Depth.....

PRODUCTION

1st 24 hrs. Nat.....

1st 24 hrs. after shot.....

Gas..... Cu. Ft.

Dry Hole.....

Abandoned.....

Date

8/30/33 192 O. Manschuet Scout

no work

Returned	
Cards	<i>[initials]</i>
Tracing	<i>[initials]</i>
France Map	<i>[initials]</i>
Scarborough Map	<i>[initials]</i>
Moody Map	<i>[initials]</i>
Scarborough Plat Book	
Moody Plat Book	

Map No. 46 Sec. 10 Twp. 19 R. 10W

Well No. J-Brandenstein

Atlantic Company

Contractor

COMPLETED

SECTION PLAT

Ft. from N. Line

660 Ft. from S. Line

660 Ft. from E. Line

Ft. from W. Line

QWD 0

Location

Rig up

Drilling and Remarks:

flow 970.
bbls-10 hrs

RECORD

Cased in., ft.

Sand

Gas

Oil

Total Depth 3044

PRODUCTION

1st 24 hrs. Nat.

1st 24 hrs. after shot

Gas Cu. Ft.

Dry Hole

Abandoned

Date

2-14-34 O. Manschreck Scout

no seal

Returned

Returned _____
Cards _____ RAS
_____ OKK
France _____ K X
