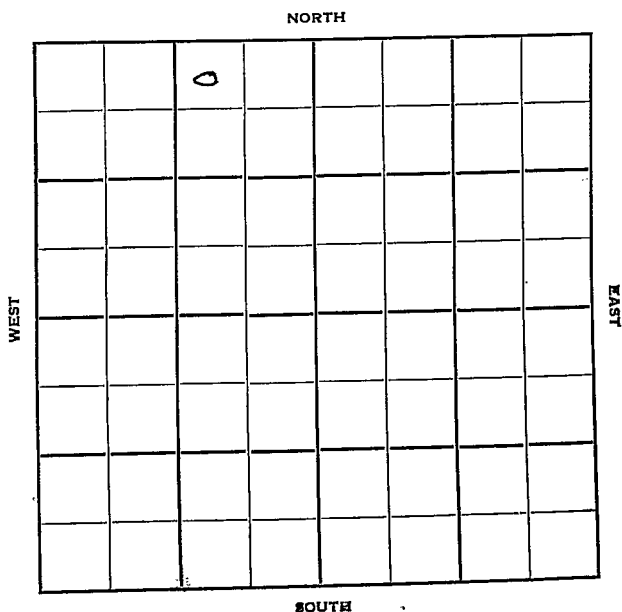


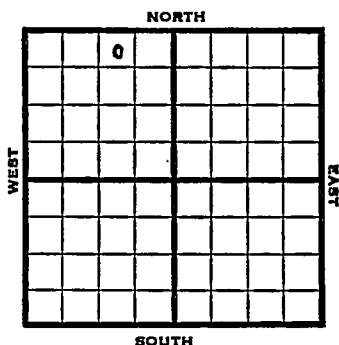
Section 10 Township 19 Range 10WWell No. #1 BoldtCompany Lewis Drlg.

Rice

KANSAS ✓

Sec. 10 Twp. 19 R. 10WWell No. #1 Boldt FarmLewis Drlg. CompanyLindsley Contractor

Wildcat

330 Ft. from N. Line Ft. from S. Line990 Ft. from E. Line Ft. from W. LineNW $\frac{1}{4}$ NW NE NW

1952 Elev. 1748' REPORT

11/12 RUR

11/20 8" @ 16 $\frac{1}{4}$ Lans. 2988'
Drlg. 2996'11/27 Spud 11-10-52
D&A

TD 3350'

8" @ 16 $\frac{1}{4}$

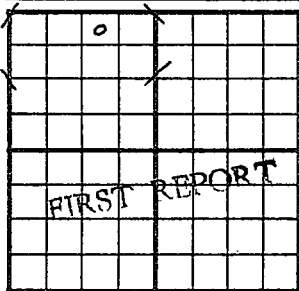
Heeb 2838, Br. Lime 2966,

Lans 2988, Cong 3292

TD 3350

D&A

ABANDONED

County Rice State KansasSec. 10 (Blk. Twp.) 19 (Sur. Rge.) 10W Map No.Operator Lewis Drlg.Well No. 1 Farm BoldtElev. Location NW NE NW330 Ft. From N Line NW990 Ft. From E Line Quarter1st. Report NOV 12 1952

Completion

Remarks

Lindsley - Contr.

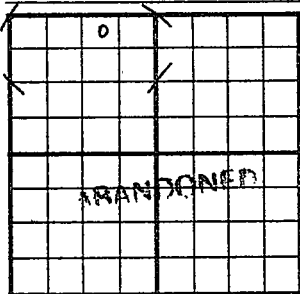
Spudding Date

Drlg. Data WildcatRUR

J. G. McGEHEE

Scout Cards	40
Land Small Map	
Land Wall Map	35
Tracings	
France Map	
Pierce Map	
Misc.	

NOV 14 1932

County Rice State KansasSec. 10 (Blk.
Twp.) 19 (Sur.
Rge.) 10W Map No.Operator Lewis Drlg.Well No. 1 Farm BoldtElev. 1748 Location NW NE NW330 Ft. From N Line NW990 Ft. From E Line Quarter1st. ReportCompletion NOV 26 1952Remarks WildcatLindsley - Contr.Spudding Date 11-10-52Drlg. Data D & A TD 33508" @ 164 Heeb. 2838 Br. line 2966Lans. 2988 Cong. 3292 TD 3350D & A

J. G. McGEHEE

Scout Cards	10
Land Small Map	
Land Wall Map	3
Tracings	
France Map	
Pierce Map	
Misc	

DEC 4 1952

Orig. Data