



Mr Pherson

Map No. KANSAS Sec. 10 Twp. 19 R. 2<sup>W</sup>

Well No. 4 - Hill Farm  
Shell Pit Company


1320 Ft. from N. Line

\_\_\_\_\_ Ft. from S. Line

330 Ft. from E. Line

\_\_\_\_\_ Ft. from W. Line

Elev. 1560

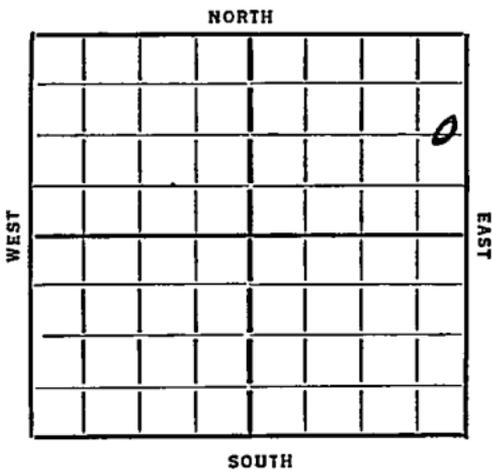

REPORT

Date	REPORT
1935	
10/2	Location
10/10	Spud
11/1	2960 Halliburton test Mud & Gas log 3378
11/7	6" 3401 Dlg cement
11/14	3409 300' Wtr Well PB 3406
11/21	Top Viola 3402 SD 3409 PB 3406 Re cementing
11/29	Swabbed 1/4" fbl oil & 10 lbs Wtr per hr S.D.O.
12/6	PB to 2985 WOC
12/13	Perforated pipe 2935-60 1100' fluid in hole Top 200' all water Pumped 30 dib @ 380 Wtr 23 hrs. Natural
	2nd test P. 170 oil 350 W. 24 hrs. Test
12/19	pumped 12" oil & 200 water Well acidize

OVER

12/23 Viola 3402

TD 3409

AB 2988

120 Oil

200 Water

COMPLETED

**KANSAS**

Map No. 43 Sec. 10 Twp. 19 R. 2W

Well No. H-Hill

Shell Pet Company

Contractor

**FIRST REPORTS**

1320 Ft. from N. Line

..... Ft. from S. Line

330 Ft. from E. Line

..... Ft. from W. Line

**SECTION PLAT**

			○

Location

Rig up.....

Drilling and Remarks:

**RECORD**

Cased.....in., .....ft.

Sand.....

Gas.....

Oil.....

Total Depth.....

**PRODUCTION**

1st 24 hrs. Nat.....

1st 24 hrs. after shot.....

Gas.....Cu. Ft.

Dry Hole.....

Abandoned.....

Date 10-7-35 192.....

**ORVAL MANNSCHRECK**  
Scout

Returned	
Cards	<i>RAA</i>
Tracing	<i>GP</i>
France Map	<i>X</i>
Search of Index	<i>X</i>
Map of Me	<i>X</i>
Book	
Book	

Map No. 43 Sec. 10 Twp. 19 R. 2W

Well No. 4-Hill

Shell Pit Company

Contractor


SECTION PLAT

1320 Ft. from N. Line

Ft. from S. Line

330 Ft. from E. Line

Ft. from W. Line

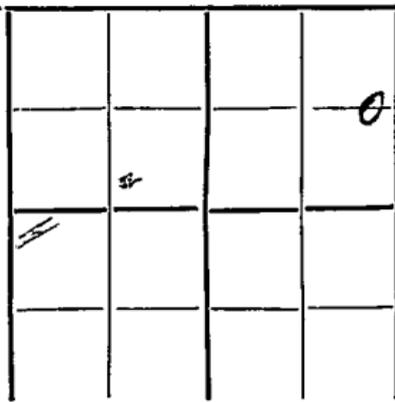

Location

Rig up

Drilling and Remarks:

P.B. 2988

120 oil  
200 water

RECORD

Cased        in.,        ft.

Sand Yield 3407

Gas

Oil

Total Depth 3409

PRODUCTION

1st 24 hrs. Nat.       

1st 24 hrs. after shot       

Gas        Cu. Ft.

Dry Hole       

Abandoned       

Date

ORVAL HANK TRUCK

12-23-35 192

Scout



Returned	<i>CM</i>
Cards	<i>CM</i>
Tracing	<i>Joe</i>
France Map	<i>CM</i>
Scarborough Map	<i>CM</i>
Muddy Map	<i>CM</i>
Scarborough Pic Book	<i>CM</i>
Muddy Pic Book	<i>CM</i>