




Mc Pherson

Form 252-A  
5M 4-32 MPC

Map No. **KANSAS** Sec. 10 Twp 19 R. 2<sup>W</sup>

Well No. 2 Johnson Farm  
Joe Rush Company

330 Ft. from N. Line  
     Ft. from S. Line  
     Ft. from E. Line  
330 Ft. from W. Line

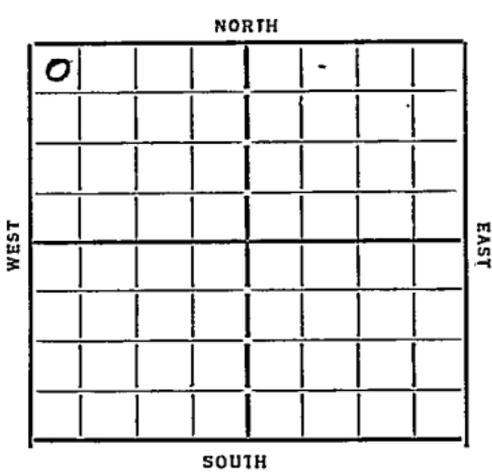

Date	REPORT
1934	
5/16	Location
5/25	— —
5/31	Bldg Rig
6/7	Spudding
6/14	dly 1340
6/21	SD 1340
6/28	dly 2252 10" 1669 H 77 2140
7/5	K.C.L. 2327 6" 2327 dly 2380
7/12	—
7/19	SD 2380
7/26	— 8/2 — 8/9 — 8/16 —
8/23	—
8/29	K.C.L. 2327 TD 2393 Dr A
<b>ABANDONED</b>	

*Macpherson*  
Form 26 - FM Bks. - 2-29

**KANSAS**

Map No. 43 Sec. 10 Twp. 19 R. 2W

Well No. 2 - Johnson

Joe Rush Company

Contractor

**FIRST REPORTS**

**SECTION PLAT**

330 Ft. from N. Line

\_\_\_\_\_ Ft. from S. Line

\_\_\_\_\_ Ft. from E. Line

330 Ft. from W. Line

0			

Location

Rig up \_\_\_\_\_

Drilling and Remarks:

**RECORD**

Cased \_\_\_\_\_ in., \_\_\_\_\_ ft.

Sand \_\_\_\_\_

Gas \_\_\_\_\_

Oil \_\_\_\_\_

Total Depth \_\_\_\_\_

**PRODUCTION**

1st 24 hrs. Nat. \_\_\_\_\_

1st 24 hrs. after shot \_\_\_\_\_

Gas \_\_\_\_\_ Cu. Ft.

Dry Hole \_\_\_\_\_

Abandoned \_\_\_\_\_

Date

5-16-34 19

**ORVAL MANNSCHRECK**

Scout

*Josephson*

*1934*

Map No. 43 Sec. 10 Twp. 19 R. 2W

Well No. 2-Johnson

Joe Ruck Company

Contractor

**ABANDONED**

**SECTION PLAT**

330 Ft. from N. Line

\_\_\_\_\_ Ft. from S. Line

\_\_\_\_\_ Ft. from E. Line

330 Ft. from W. Line

0			

Location \_\_\_\_\_

Rig up \_\_\_\_\_

Drilling and Remarks:

*W & H*

**RECORD**

Cased \_\_\_\_\_ in., \_\_\_\_\_ ft.

Sand K.C.L. 2327

Gas \_\_\_\_\_

Oil \_\_\_\_\_

Total Depth 2393

**PRODUCTION**

1st 24 hrs. Nat. \_\_\_\_\_

1st 24 hrs. after shot \_\_\_\_\_

Gas \_\_\_\_\_ Cu. Ft.

Dry Hole \_\_\_\_\_

Abandoned \_\_\_\_\_

Date

8-29-34<sub>19</sub>

**ORVAL MANNSCHRECK**  
Scout