

SECTION 10 TOWNSHIP 19 RANGE 2W

WELL NO. #1 Austin #2 Ostlund


COMPANY Jess Cling & ~~Veeder~~

NORTH

~~SE~~ ~~NE~~ ~~SE~~

WEST

EAST

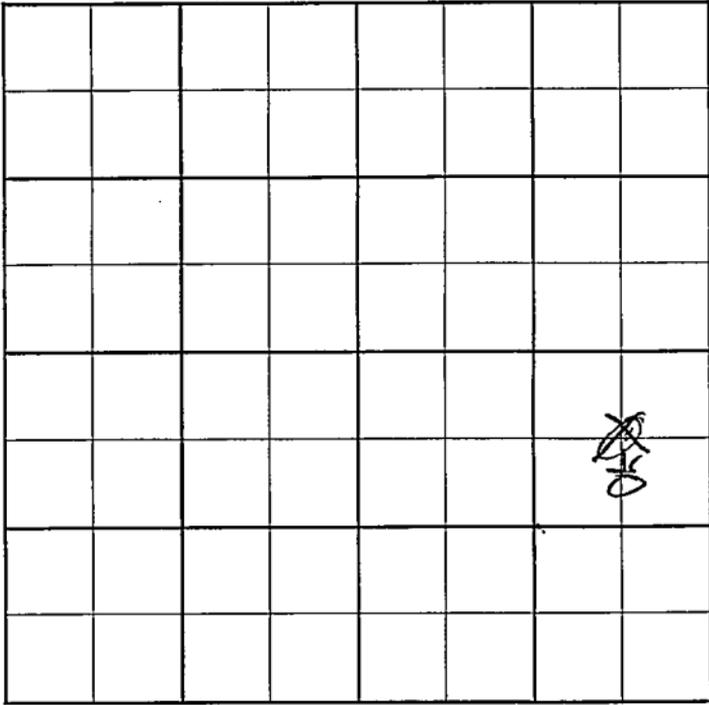

SOUTH

County McPherson Elev. _____
 Sec. 10 Twp. 19 Rge. 2W
 Company Jess Cling & Veeder
 Farm Name Austin No. 1

TOPS	DEPTH	LOG	DATUM
Anh.			
Tp.			
H.			
Tr.			
Dg.			
BL.			
L.			
K.C.			
B.K.C.			
Ce.			
C.			
M.			
M.			
K.			
Mz.			
Mo.			
V.			
S.			
S.			
A.			
R.			
PE.			
G.			
T.D.			

Loc in Sec. C NE SE
 Geol. _____
 Contr. Veeder
 Pool Ritz-Canton

FIRST REPORT
 MAY 1 1957
 0

Date Comm. _____
 Location _____

Co.
 Lse.
 No.
 Sec.
 T.
 R.

CORRECTION

FORM 513 SUNRAY

County Wagon Elev. 1557
 Sec. 10 Twp. 19 Rge. 21
 Company Josef Kling & V...
 FarmName Ostlund No. 72

	TOPS	DEPTH	LOG	DATUM
Anh.				
Tr.				
H.				
Tr.				
Dg.				
Bl.				
L.				
K.C.				
B.K.C.				
Ce.				
C.				
M.		2918		
M.				
K.				
Mz.				
Mo.				
V.				
S.				
S.				
A.				
R.				
PE.				
G.				
TD.		2948		

Loc. in Sec. 72
52 NE SE
 Geol. _____
 Contr. Weeder
 Pool _____
 Pits - Anton

COMPLETE	
8	0
AUG 7 '57	

Date Comm. Wagon @ 57 Loc MAY 15 '57 ✓ MAY 22 '57
5-15-57 '10" @ 149/125
7" 2918 MAY 29 '57 WACT JUN 5 '57 RUCT
JUN 12 '57 JUN 19 '57 ✓ E.A. 20 '57 DD 2955
JUL 3 '57 JUL 10 '57 JUL 17 '57 JUL 24 '57 JUL 31 '57
AUG 8 '57 est P. 25 Bopdt 450
Bwd.

Co. No. Sec. T. R.