


McPherson

KANSAS

Section 10 Township 19 Range 2-W

Well Number K-1-Robinson

Company Joe Rush

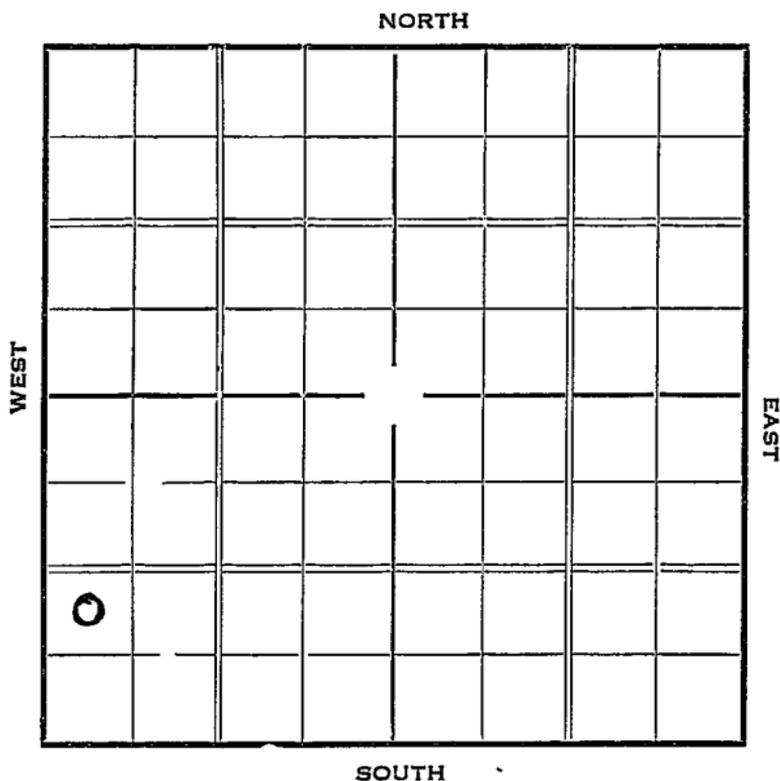

1937

7/7

5" @ 2946'.

Chat 2946'.

T.D. 3005'.

H.F.W. 2985'.

ABANDONED

Mc Pherson KANSAS

Map No. 43 Sec. 10 Twp. 19 R. 2^w

Well No. K-1 - Robinson

Joe Rush Company

Contractor

FIRST REPORT

SECTION PLAT

_____ Ft. from N. Line

990 Ft. from S. Line

_____ Ft. from E. Line

330 Ft. from W. Line

0			

Location _____

RECORD

Rig up _____

Drilling and Remarks:

15" - 91
17" - 463
Dig 505

Cased _____ in., _____ ft.

Sand _____

Gas _____

Oil _____

Total Depth _____

PRODUCTION

1st 24 hrs. Nat. _____

1st 24 hrs. after shot _____

Gas _____ Cu. Ft.

Dry Hole _____

Abandoned _____

Date

APR 28 1937

19

H. D. Hatfield Scout

220

2

22

M. H. 2/1/18

RAY



Returned	
Cards	<i>Paul</i>
Tracing	<i>Jim</i>
France Map	<i>[Signature]</i>
Scarborough Map	
Moody Map	
Scarborough Plat Book	
Moody Plat Book	

KANSAS *McPherson*

Map No. 43 Sec. 10 Twp. 19 R. 2^w

Well No. K-1-Robinson

Joe Rush Company
Contractor

ABANDONED

_____ Ft. from N. Line

990 Ft. from S. Line

_____ Ft. from E. Line

330 Ft. from W. Line

SECTION PLAT

0			

Location _____

Rig up _____

Drilling and Remarks:

HFW 2985

DVA

RECORD

Cased 5 in., 2946 ft.

Sand Chat 2946

Gas _____

Oil _____

Total Depth 3005

PRODUCTION

1st 24 hrs. Nat. _____

1st 24 hrs. after shot _____

Gas _____ Cu. Ft.

Dry Hole _____

Abandoned _____

Date

JUL 7 1937 19

H. D. Hatfield

Scout

RAY

Returned	_____
Cards	_____
Tracing	_____
France Map	_____
Scarborough Map	_____
Moody Map	_____
Scarborough Plat Book	_____
Moody Plat Book	_____

RAY