

Barton

KANSAS


DX 78-1

Section 10 Township 19 Range 13W

Well No. #1 Bissell Point

Company Schermerhorn Oil

NORTH

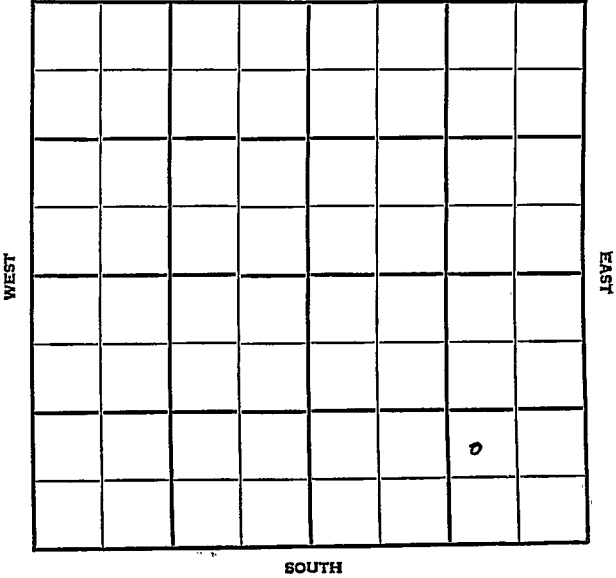

## Barton KANSAS


|                   |      |      |
|-------------------|------|------|
| SEC.              | TWP. | R.   |
| 10                | 19   | 13W  |
| WELL NO.          |      |      |
| 1 Bissell Point   |      |      |
| COMPANY           |      | FARM |
| Schermmerhorn Oil |      |      |
| CONTRACTOR        |      |      |
| Badger            |      |      |
| Wildcat.          |      |      |

\_\_\_\_\_ Ft. from N. Line

990 \_\_\_\_\_ Ft. from S. Line

990 \_\_\_\_\_ Ft. from E. Line

\_\_\_\_\_ Ft. from W. Line

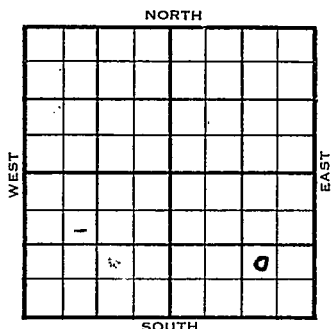

NW SE SE

| 1954 | ELEVATION   | REPORT |
|------|---|--------|
|      | 1914'   |        |
| 10/6 | Spud 9-28-54<br>8" @ 812'<br>Anhy 809'<br>rlg. 2096'   |        |
| 12/1 | Spud 9-28-54<br>Oil Well<br>TD 3520'<br>8" @ 812'<br>Anhy 809', Heeb 3119', Br. Lime 3215'<br>Lans 3229'<br>DST 3219'-46' opn $\frac{1}{2}$ hr, rec 10' Mud O#<br>DST 3261'-85' opn 1 hr, rec 2260' gas,<br>60' hocm 120' froggy oil, 925#<br>DST 3286'-3302' opn 1 hr, rec 60' ocm<br>O#<br>DST 3356'-87' opn $\frac{1}{2}$ hr, rec 20' Mud<br>O#<br>DST 3390'-3411' opn $\frac{1}{2}$ hr, rec 12' Mud<br>O# Cong 3461' Arb. 3475'<br>DST 3474'-81' opn $\frac{1}{2}$ hr, rec 10' Mud<br>O#<br>DST 3478'-85' opn $\frac{1}{2}$ hr, rec 5' Mud<br>O#<br>DST 3483'-90' opn $\frac{1}{2}$ hr, rec 5' Mud O# |        |

1954

Information brought forward.

12/1 DST 3488'-97' opn  $\frac{1}{2}$  hr, rec 5' Mud  
0#  
DST 3496'-3505' opn  $\frac{1}{2}$  hr, rec 5' Mud  
0#  
- DST 3503'-10' opn  $\frac{1}{2}$  hr, rec 5' Mud  
800#  
DST 3513'-20' opn  $\frac{1}{2}$  hr, rec 70' wcm  
800#  
DST 3510'-20' opn 1 hr, rec 240' mcw  
900#  
TD 3520'  
5" @ 3520'  
CO to 3520  
36/ 3297-3302 S/ 2 goph  
250 M-A S / 7 goph 500 A S/ 10 boph  
PB 3290  
36/ 3276-81 500 A S/ 15 boph  
Comp 172 bopd 2% Wtr.

COMPLETED


FABEN GILSTRAP

County Barton State Kansas  
 Sec. 10 (Blk. 19 (Sur. 13W Map No.  
Twp. Rge.

Operator Schermerhorn Oil

Well No. 1 Farm Bissell Point

Elev. 1914 Location NW SE SE

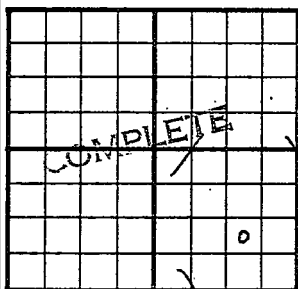

990 Ft. From S Line SE

990 Ft. From E Line Quarter

1st. Report

Completion DEC 1 1954

Remarks Wildcat

Badger - Contr.

Spudding Date 9-28-54

Drlg. Data Oil well TD 3520

8" @ 812 Anhy 809 Heeb. 3119

Br. lime 3215 Lans. 3229 DST 3219-46

open  $\frac{1}{2}$  hr. Rec. 10' mud 0# DST 3261-

85 open 1 hr. Rec. 2260' gas 60' hoem

120' froggy oil 925# DST 3286-3302

open 1 hr. Rec. 60' ocm 0#

DST 3356-87 open  $\frac{1}{2}$  hr. Rec. 20' mud

0# DST-3390-3411 open  $\frac{1}{2}$  hr. Rec.

12' mud 0# Cong. 3461 Arb. 3475

DST 3474-81 open  $\frac{1}{2}$  hr. Rec. 10' mud

0# DST 3478-85 open  $\frac{1}{2}$  hr. Rec. 5' mud

0# DST 3483-90 open  $\frac{1}{2}$  hr. Rec. 5' mud

0# DST 3488-97 open  $\frac{1}{2}$  hr. Rec. 5' mud

0# DST 3496-3505 open  $\frac{1}{2}$  hr. Rec.

FABEN GIL STRAP

Drlg. Data

5' mud 0# DST 3503-10 open  $\frac{1}{2}$  hr.

Rec. 5' mud 800# DST 3513-20

open  $\frac{1}{2}$  hr. Rec. 70# mud S 800#

DST 3510-20 open 1 hr. Rec. 240' mcw

900# TD 3520 5" @ 3520 CO to 3520

36/ 3297-3302 S/ 2 goph 250 M-A

S/ 7 goph 500 A S/ 10 boph PB 3290

36/ 3276-81 500 A S/ 15 boph

Comp. 172 bopd 2% wtr.