

Scott

KANSAS

10

19

31W


SECTION _____ TOWNSHIP _____ RANGE _____

#1 Albert Popp

WELL NO. _____

W.L. Hartman

COMPANY _____

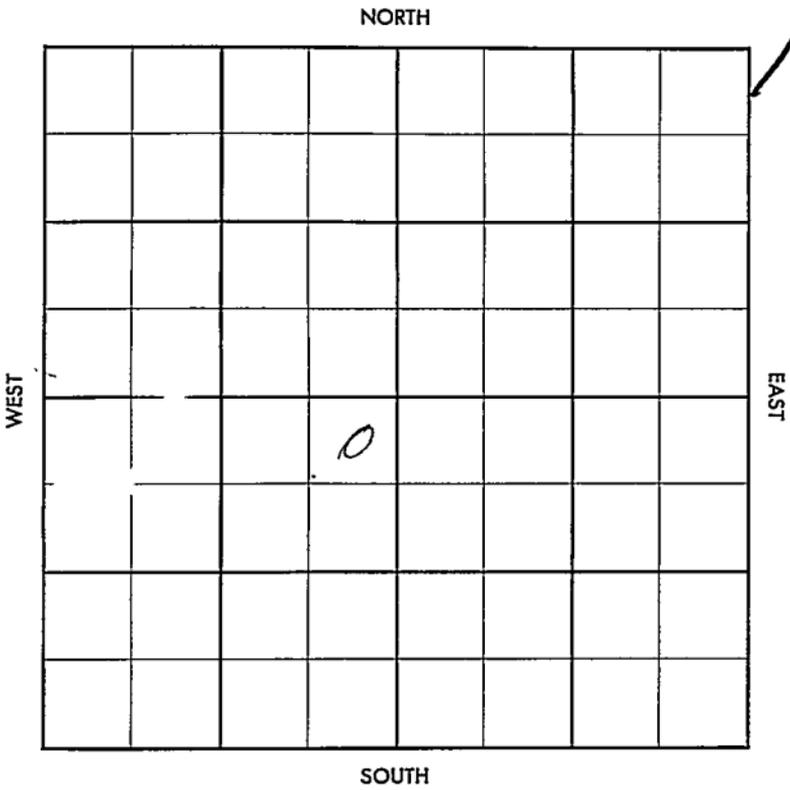

Scott

KANSAS

SEC.	TWP.	R.
10	19	31W

WELL NO. #1 Albert Popp FARM

COMPANY W. L. Hartman


CONTRACTOR Co Tools
Grigsby

_____ FT. FROM N. LINE

_____ FT. FROM S. LINE

_____ FT. FROM E. LINE

_____ FT. FROM W. LINE

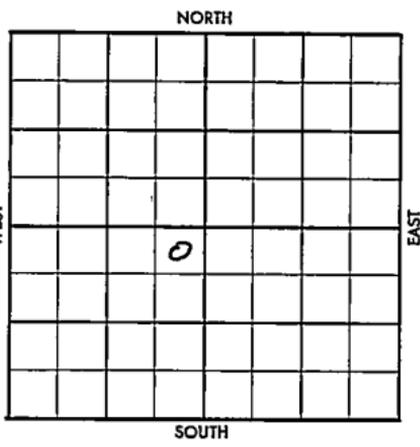

NE NE SW

1956	ELEVATION	REPORT
------	-----------	--------

9-12	MIR	
------	-----	--

County Scott Elev. _____
 Sec. 10 Twp. 19 Rge. 31W
 Company W. L. Hartman
 Farm Name Albert Popp No. 1

TOPS	DEPTH	LOG	DATUM
Anb.			
Tr.			
H.			
Tr.			
Dg.			
Bl.			
L.			
K.C.			
B.K.C.			
Ce.			
C.			
M.			
M.			
K.			
Mz.			
Me.			
V.			
S.			
S.			
A.			
R.			
PE.			
G.			
T.D.			

Loc. in Sec. NE NE SW
 Geol. _____
 Contr. _____
 Co. tools _____
 Pool _____
Grigsby

SEP 12 '36
0

 FIRST REPORT

Date Comm. M I R

~~W. L. Hartman~~

Co.
 Sec.
 T.
 R.

County Scott Elev. 29481
 Sec. 10 Twp. 19 Rge. 37W
 Company W. W. Hartman
 Farm Name Albert Popp No. 1

TOPS	DEPTH	LOG	DATUM	Loc. in Sec.
Anh.				17 17E SW
Ip.				
H.	3901			
Tr.				
Dg.				
Bl.				
L.	3942			Geol.
K.C.				Contr.
B.K.C. <u>Marion</u>	4358			Co. tools
Ce.	4486			Pool
C.				Grigsby
M.	4566			<div style="border: 1px solid black; padding: 5px; text-align: center;"> <p>ABANDONED</p> <p>o</p> <p>JAN 23 '57</p> </div>
M.				
K.				
Mz.				
Me				
V.				
S.				
A.				
R.				
PE.				
G.				
T.D.	4640			

Date Comm. M I R SEP 19 '56 9-11-56 8 5/8
245/175 3290 SEP 25 '56 4420
OCT 3 '56 5 1/2 4640/175 OCT 10 '56 o
OC. 17 '56 NOV 24 '56 ✓ OCT 31 '56 ✓ S.D.
NOV 7 '56 ✓ NOV 13 '56 NOV 21 '56 NOV 28 '56 ✓ DEC 5 '56
DEC '56 DEC 13 '56 DEC 26 '56 ✓ JAN 2 '57 ✓
JAN '57 ✓ JAN '57 ✓ JAN 2 '57 (Drilled in 170 dope not on pump)