

Rush


KANSAS

DX 78-1

Section 10 Township 19 Range 20W

Well No. #1 E. Webs "A"

Company Republic Natural & Natural O & G

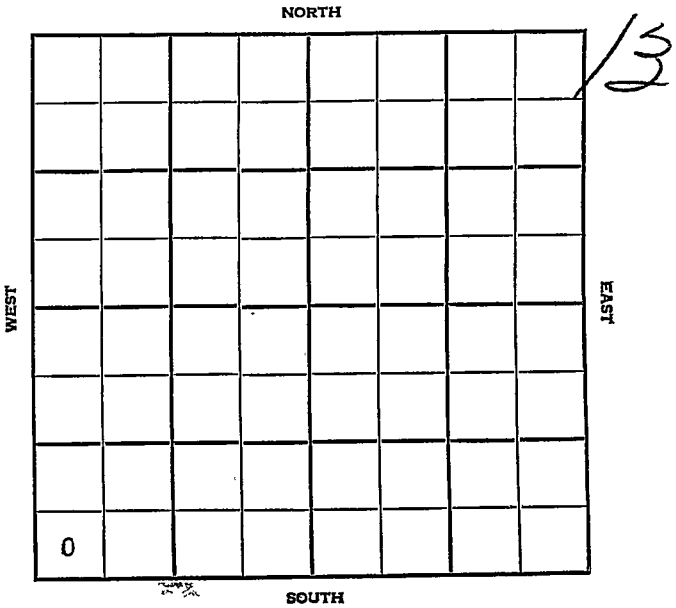

KANSAS

SEC.	TWP.	R.
10	19	20 W

WELL NO.

1 E. Webs "A"

FARM

COMPANY

Republic Natural & Natural O & G

CONTRACTOR

Natural O & G

Webs Pool

Ft. from N. Line

330 _____ Ft. from S. Line


Ft. from S. Line

Ft. from E. Line

330 Ft. from W. Line

Ft. from W. Line

SW SW SW

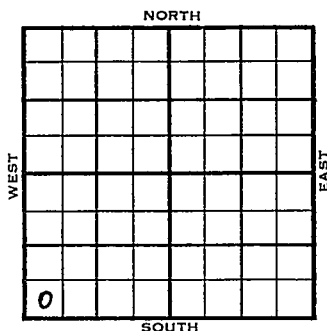

1954	ELEVATION 2198'	REPORT
12/29	RUR	
1955 2/2	Spud 12-29-54 - Oil Well TD 4300' 8" @ 195' Cherokee 4206' DST 4205-11', opn 1 hr., rec. 3770' oil, 1300# DST 4210-26', opn 1 hr., rec. 3640' oil, 1300# DST 4228-44', opn 1 hr., rec. 2450' SW, 1160# Miss. 4285' DST 4247-70', opn 1 hr., rec. 25' mud, 1095# TD 4300' 5" @ 4299' 48/4210-18 P/134 bo 16 hrs. Comp. 1146 bopd	
		COMPLETED

DX-78

COMPLETED

County	Rush		State	Kansas
Sec.	10 (Blk. Twp.)	19 (Sur. Rge.)	20W	Map No.
Operator	Republic Natural & Natural Oil & Gas			
Well No.	1	Farm	E. Wells "A"	
Elev.	Location		SW SW SW	


330	Ft. From	S	Line	SW
330	Ft. From	W	Line	Quarter
1st. Report DEC 29 1954				
Completion				
Remarks				
Natural O & G - Contr.				
Spudding Date				

Drbg. Data

Webb Pool

R U R

FABEN GILSTRAP

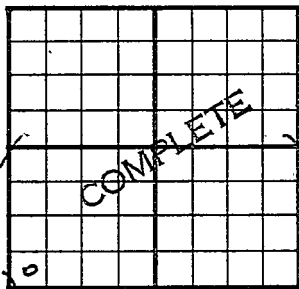County Rush State KansasSec. 10 (Blk.
Twp.) 19 (Sur.
Rge.) 20W Map No.Operator Republic Natural & Natural O & GWell No. 1 Farm E. Webs "A"Elev. 2198 Location SW SW SW330 Ft. From S Line SW330 Ft. From W Line Quarter

1st. Report

Completion FEB 2 1955Remarks Webs PoolNatural O & G - Contr.Spudding Date 12-29-54Drlg. Data Oil well TD 43008" @ 195 Cherokee 4206 DST 4205-11open 1 hr. Rec. 3770' oil 1300#DST 4210-26 open 1 hr. Rec. 3640' oil1300# DST 4228-44 open 1 hr. Rec.2450' sw 1160# Miss. 4285 DST 4247-70open 1 hr. Rec. 25' mud 1095#TD 4300 5" @ 4299 48/ 4210-18P/ 134 bo 16 hr. Comp. 1146 bopd

FABEN GILSTRAP