

## State Geological Survey

15-009-21382

WICHITA BRANCH

## KANSAS DRILLERS LOG

API No. 15 — 009 — 21382  
County \_\_\_\_\_ Number \_\_\_\_\_

Operator

Bankoff Oil Co.

Address

Drawer 2479 Tulsa, Okla

Well No. #1 Lease Name Eberhardt

Footage Location

910 feet from (N) (X) line 620 feet from (E) (W) line

Principal Contractor Allen Drilling Company Geologist Stephen B. Powell

Spud Date May 9, 1978 Total Depth 3354 P.B.T.D.

Date Completed May 17, 1978 Oil Purchaser Bigheart Pipe Line


S. 24 T. 19S R. 11WE W

Loc. C S/2 NW NW

County Barton

640 Acres

N

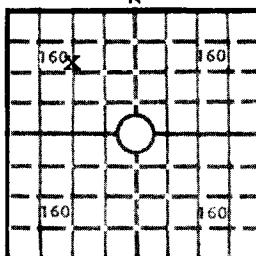

Locate well correctly

1774

Elev.: Gr.

DF 1777 KB 1779

## CASING RECORD

Report of all strings set — surface, intermediate, production, etc.

Purpose of string	Size hole drilled	Size casing set (in O.D.)	Weight lbs/ft.	Setting depth	Type cement	Sacks	Type and percent additives
Surface	12 $\frac{1}{4}$ "	8 5/8"	354'	354'	60/40 Pos Mix	250	3% CC
Production	7 7/8"	5 $\frac{1}{2}$ "	14#	3352	50/50 Pos Mix	125	

## LINER RECORD

## PERFORATION RECORD

Top, ft.	Bottom, ft.	Sacks cement	Shots per ft.	Size & type	Depth interval
			4		3323-3327

## TUBING RECORD

Size	Setting depth	Packer set at			
2"	3320				

## ACID, FRACTURE, SHOT, CEMENT SQUEEZE RECORD

Amount and kind of material used	Depth interval treated
250 Gal Mud acid	3323-27
500 Gal XXM38 acid	3323-27

## INITIAL PRODUCTION

Date of first production	Producing method (flowing, pumping, gas lift, etc.)				
May 25, 1978	Swab				


RATE OF PRODUCTION PER 24 HOURS	Oil	Gas	Water	Gas-oil ratio
	40 bbls.	none	MCF	40 bbls.

Disposition of gas (vented, used on lease or sold)	Producing interval(s)
none	3323-3327

INSTRUCTIONS: As provided in KCC Rule 82-2-125, within 90 days after completion of a well, one completed copy of this Drillers Log shall be transmitted to the State Geological Survey of Kansas, 4150 Monroe Street, Wichita, Kansas 67209. Copies of this form are available from the Conservation Division, State Corporation Commission, 3830 So. Meridian (P.O. Box 17027), Wichita, Kansas 66217. Phone AC 316-522-2206. If confidential custody is desired, please note Rule 82-2-125. Drillers Logs will be on open file in the Oil and Gas Division, State Geological Survey of Kansas, Lawrence, Kansas

## Bankoff Oil Company

DRY HOLE, SWDW, ETC.:

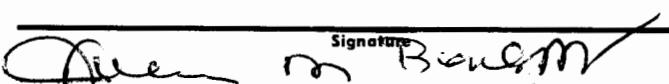Well No. 1	Lease Name Eberhart	Producer		
S 24 T 19 R 11 <sup>R</sup> <sub>W</sub>				
<b>WELL LOG</b>				
Show all important zones of porosity and contents thereof; cored intervals, and all drill-stem tests, including depth interval tested, cushion used, time tool open, flowing and shut-in pressures, and recoveries.				
FORMATION DESCRIPTION, CONTENTS, ETC.	TOP	BOTTOM	NAME	DEPTH
Anhydrite Topeka Heebner Toronto Douglas Brown Lime Lansing Base Kansas City Arbuckle	Sample 504 2627 2889 2910 2912 3010 3034 3286 3315	E. Log 507 2629 2890 2912 2923 3012 3031 3287 3311		
USE ADDITIONAL SHEETS, IF NECESSARY, TO COMPLETE WELL RECORD.				
Date Received	 Signature JULIUS M. BANKOFF Title Co-Partner June 1, 1978 Date			

*Duplicate*

15-009-21382

24-19-11W

DRILLER'S WELL LOG

DATE COMMENCED: 5-9-78  
DATE COMPLETED: 5-17-78

Bankoff Oil Company  
Eberhardt #1  
Approx. S/2 NW NW, Sec. 24-19-11W,  
Barton County, Kansas

ELEVATION: 1779' K.B.  
1774' G.L.

FORMATION DATA

507- 535'	Anhydrite
2629-2890'	Lime
2890-2895'	Shale
2912-2912'	Lime
2912-3012'	Lime
3012-3031'	Lime and Shale
3031-3287'	Lime
3287-3311'	Lime and Shale
3311-3354'	Dolomite
3354'	RTD

Anhydrite	507
Topeka	2629
Heebner	2890
Toronto	2912
Brown Lime	3012
Lansing	3031
Base Kansas City	3287
Arbuckle	3311
RTD	3354

RECEIVED  
STATE CORPORATION COMMISSION  
CONSERVATION DIVISION  
WICHITA, KANSAS  
JUN 13 1978

SURFACE PIPE:

Ran 9 Jts. Used 28# 8 5/8" Casing.  
Tally 247'. Set 354' w/250 sks.  
60-40 Pozmix, 3% c.c. By Sun Cementing.  
Did not circulate - 15' from surface.

PRODUCTION PIPE:

Ran 84 Jts. New 14# 5 1/2" Casing.  
Tally 3356'. Set @ 3353' w/125 sks.  
50-50 Pozmix salt saturated.  
By Sun Cementing.

A F F I D A V I T

STATE OF KANSAS } ss.  
COUNTY OF BARTON }

DALE L. SMITH, of lawful age, does swear and state that the facts and statements herein contained are true and correct to the best of his knowledge.