

API No. 15 — 009 — 21508  
County Number

Operator

Bankoff Oil

**Address**

Drawer 2479 Tulsa, Ok.

Well No.

# 2

**Lease Name**

Eberhart

**Footage Location**

330

feet from (N) (S) line

480

feet from  $\begin{pmatrix} X \\ E \end{pmatrix}$  (W) line**Principal Contractor**

Allen Drilling Co.

## Geologist

Steven Powell

**Spud Date**

11/28/78

**Total Depth**

3337'

**P.B.T.D.**

**Date Completed**

12/4/78

**Oil Purchaser**


## Dry Hole

S. 24 T. 195 R. 11 W E  
W

Loc. 150'E of SW SW NW

County Barton

**640 Acres**  
**N**

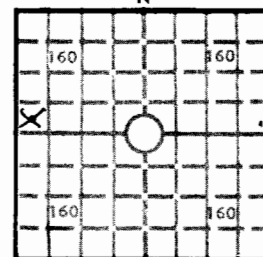

**Locate well correctly**

Elev.: Gr. 1772'

DF \_\_\_\_\_ KB 1777'

## CASING RECORD

**Report of all strings set—surface, intermediate, production, etc.**

Purpose of string	Size hole drilled	Size casing set (in O.D.)	Weight lbs/ft.	Setting depth	Type cement	Sacks	Type and percent additives
Surface		8 5/8"		353'	common	300	60/40, 2%, 3% cc

## LINER RECORD

## PERFORATION RECORD

Top, ft.	Bottom, ft.	Sacks cement	Shots per ft.	Size & type	Depth interval
TUBING RECORD					
Size	Setting depth	Packer set at			


## ACID, FRACTURE, SHOT, CEMENT SQUEEZE RECORD

Amount and kind of material used	Depth interval treated

## INITIAL PRODUCTION

Date of first production dry hole		Producing method (flowing, pumping, gas lift, etc.)			
<b>RATE OF PRODUCTION PER 24 HOURS</b>	<b>Oil</b>  bbls.	<b>Gas</b>  MCF	<b>Water</b>  bbls.	<b>Gas-oil ratio</b>  CFPB	
Disposition of gas (vented, used on lease or sold)			Producing interval(s)		

**INSTRUCTIONS:** As provided in KCC Rule 82-2-125, within 90 days after completion of a well, one completed copy of this Drillers Log shall be transmitted to the State Geological Survey of Kansas, 4150 Monroe Street, Wichita, Kansas 67209. Copies of this form are available from the Conservation Division, State Corporation Commission, 3830 So. Meridian (P.O. Box 17027), Wichita, Kansas 66217. Phone AC 316-522-2206. If confidential custody is desired, please note Rule 82-2-125. Drillers Logs will be on open file in the Oil and Gas Division, State Geological Survey of Kansas, Lawrence, Kansas

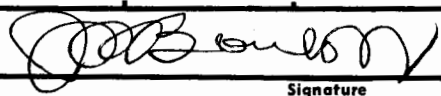Operator Bankoff Oil Company		DESIGNATE TYPE OF COMPLETION: OIL, GAS, DRY HOLE, SWDW, ETC.:			
Well No. 2	Lease Name Eberhart		dry hole		
S 24 T 19 R 11 Ex W					
<b>WELL LOG</b> Show all important zones of porosity and contents thereof; cored intervals, and all drill-stem tests, including depth interval tested, cushion used, time tool open, flowing and shut-in pressures, and recoveries.			SHOW GEOLOGICAL MARKERS, LOGS RUN, OR OTHER DESCRIPTIVE INFORMATION.		
FORMATION DESCRIPTION, CONTENTS, ETC.		TOP	BOTTOM	NAME	DEPTH
Anhydrite		507			
Topeka		2626			
Heebner		2892			
Toronto		2910			
Brown Lime		3013			
Lansing		3033			
Base Kansas City		3288			
Arbuckle		3313			
RTD		3337			
USE ADDITIONAL SHEETS, IF NECESSARY, TO COMPLETE WELL RECORD.					
Date Received	 Signature Julius M. Bankoff, Co-Partner Title December 11, 1978 Date				