


24-19-11W

WELL LOG BUREAU KANSAS GEOLOGICAL SOCIETY  
412 Union National Bk. Bldg., Wichita, Kansas

Company - VICKERS PETROLEUM CO., INC.  
Farm - Herr "A" No. 5.

SEC. 24 T. 19 R. 11 W  
NW NE NW

Total Depth. 3388'  
Comm. 12-21-45 Comp. 1-9-46  
Shot or Treated.  
Contractor.  
Issued. 1-26-46

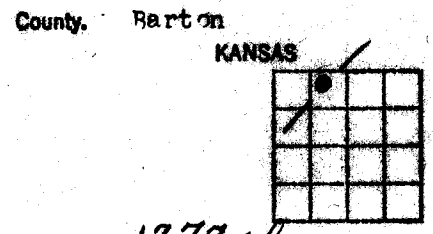

CASING:  
1 3/4" 158' Cem.  
5 1/2" 3345' Cem.

Elevation. 1777' sk

Production. Dry

Figures Indicate Bottom of Formations.

sand 0-100  
shale & shells 158  
red bed & shells 500  
anhydrite 525  
shale, shells & red bed 770  
shale & shells 1020  
shale & salt 1225  
shale & shells 1285  
lime & shale 1430  
lime brkn. 1605  
lime & sand 1710  
lime sdy & shale 1795  
lime brkn 1910  
shale & lime 2050  
lime & shale 2110  
shale & shells 2215  
shale 2345  
shale & lime 2705  
lime 2975  
shale 3060  
lime 3290  
shale & lime 3340  
lime 3388  
Total Depth

TOPS:  
Lansing Brown 3027 DF  
Lansing White 3043 DF  
Marmaton 3284 DF  
Arbuckle 3336 DF  
Rotary TD 3353 DF  
Arbuckle (cable tools) 3388

Soft from 3147 to 53  
Soft from 3190 to 94  
Show of oil 3345 to 55  
No increase in oil, 1 1/2 BW  
3388  
Set Lane Well Plug at 3245  
Perf. 12 shots 3142 to 53,  
300' wtr. 2 1/2 hrs, no oil