

KANSAS

Barton

FORM 51 25M 3-49 PETROL

Section 11 Township 19 Range 12-W

Well No. #2 Kultgen "B"


Company Aladdin etal.
Cheyenne View

NORTH

10

WEST

EAST

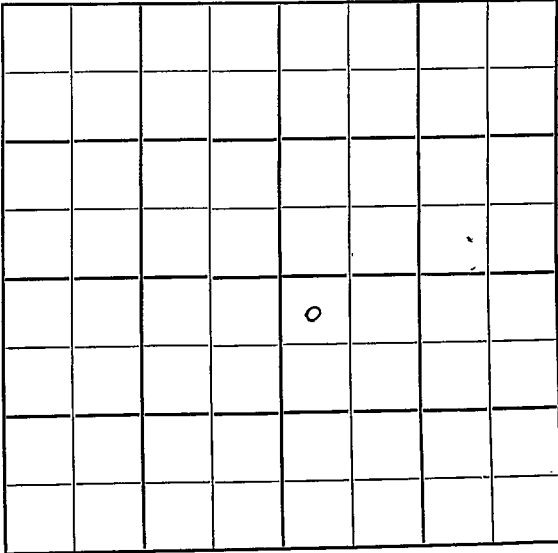

SOUTH

Barton

KANSAS

Sec. 11 Twp. 19 R. 12W

Well No. #2 Kultgen "B" Farm

Aladdin et al Company

Cheyenne View Contractor


330' Ft. from N. Line

Ft. from S. Line

Ft. from E. Line

330' Ft. from W. Line

NW NW SE

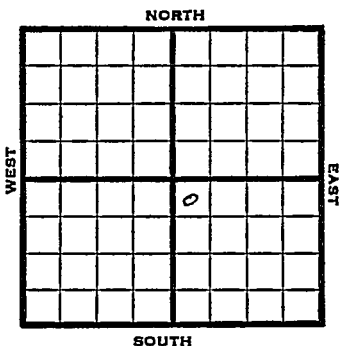

1950

Elev 1825' REPORT

3/1

Location

4/5

TD 3377'

8"@ 230'

Lans 3103'

Arb. 3370'

5"@ 3375'

Perf 7/3096-99'

Perf 23/3099-3107'

Perf 5/3107-09'

Perf 18/3122-28'

Perf 28/3128-31'

Perf 22/3140-46'

Perf 23/3146-54'

Perf 24/3163-71

Used 3000 acid

2070 BOBD

Comp

COMPLETED

Kansas

Cheyenne View

Map No. _____ Sec. 11 Twp. 19 R. 12W

Well No. 2 Kultgen "B"

Aladdin etal. _____ Company

_____ Contractor

NW NW SE

SECTION PLAT

330 Ft. from N. Line

_____ Ft. from S. Line

_____ Ft. from E. Line

330 Ft. from W. Line



Barton County

Location X

Rig up _____

Drilling and Remarks:

RECORD

Cased _____ in., _____ ft.

Sand _____

Gas _____

Oil _____

Total Depth _____

PRODUCTION

1st 24 hrs. Nat. _____

1st 24 hrs. after shot _____

Gas _____ Cu. Ft.

Dry Hole _____

Abandoned _____

Date

MAR 1 1950 19

J. E. TYRA

Scout

1953 3 1950

1	Cards	Map
2	Photo	
3	Photo	
Kansas

Map No. _____ Sec. 11 Twp. 19 R. 12WWell No. 2 Kultgen "B"

_____ Aladdin etal. _____ Company


_____ Contractor

NW NW SE

E. 1825
SECTION PLAT330 Ft. from N. Line

_____ Ft. from S. Line

_____ Ft. from E. Line

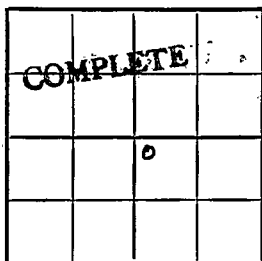330 Ft. from W. Line

Barton County

Location _____

Rig up _____

Drilling and Remarks:

8" @ 230
San 3103
ant 3370
5' @ 3375
(over)

RECORD

Cased _____ in., _____ ft.

Sand _____

Gas _____

Oil _____

Total Depth 3377

PRODUCTION

1st 24 hrs. Nat. _____

1st 24 hrs. after shot _____

Gas _____ Cu. Ft.

Dry Hole _____

Abandoned _____

Date

APR 5 1950 19

J. E. TYRA
Scout

perf 7/3096-99

" 23/3099-3107

" 5/3107-09

" 78/3122-28

" 28/3128-31

" 23/3140-46

" 23/3146-54

" 24/3163-71 used 3000 Acid

2070 BOPD

Scout Cards

Land Small Map

Land Wall Map

Tracings

France Map

Pierce Map

Misc.

APR 14 1950