


Section 11 Township 19 Range 12W

Well No. #1 Panning

Company Lion Oil

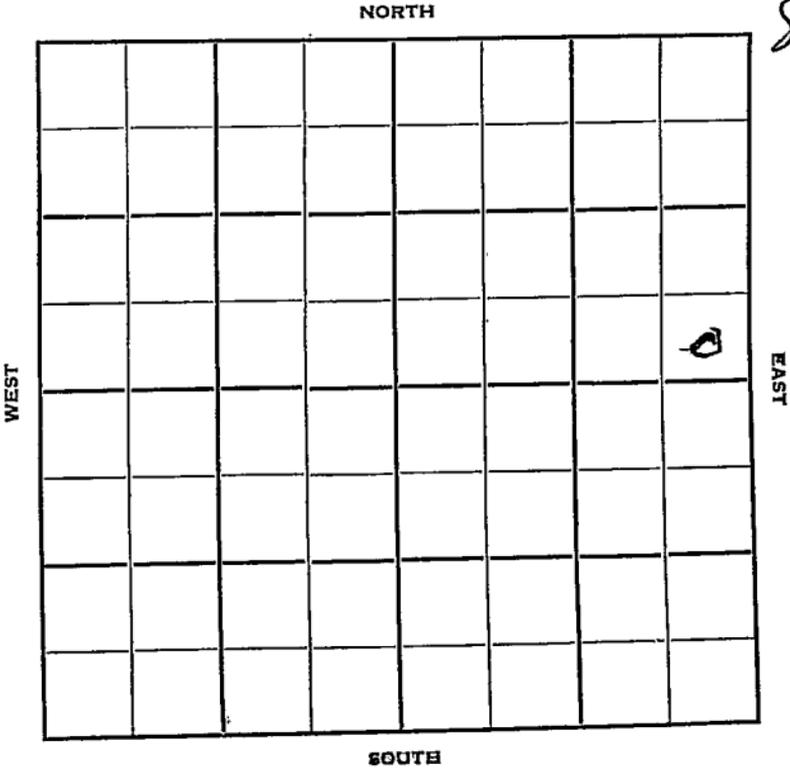

Sec. 11 Twp. 19 R. 12W

Well No. #1 Panning Farm

Lion Oil Company

Rine Drlg. Contractor

Cheyenne View


_____ Ft. from N. Line

330' Ft. from S. Line

330' Ft. from E. Line

_____ Ft. from W. Line

SE SE NE

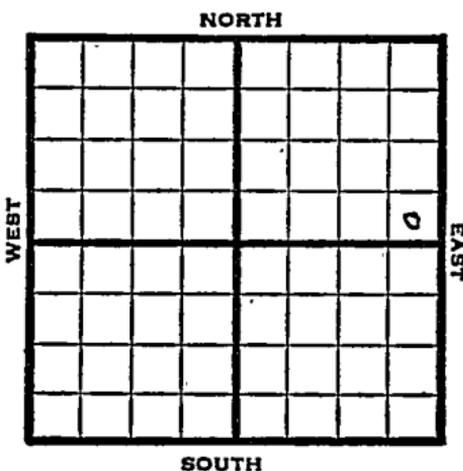

SOUTH

1950

Elev 1817' REPORT

1/25

Location

3/15


TD 3406'
 8" @ 248'
 5" @ 3400'
 Lans 3110'
 Cong 3371'
 Arb. 3399'
 Plug back to 3125'
 24/3110-14
 P 89 BOPD
 Comp

COMPLETED

Map No. _____ Sec. 11 Twp. 19 R. 12WWell No. 1 PanningLion Oil CompanyRine Drlg. Contractor

SE SE NE

SECTION PLAT

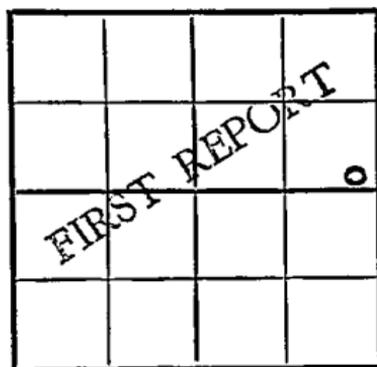

_____ Ft. from N. Line

330 Ft. from S. Line330 Ft. from E. Line

_____ Ft. from W. Line

Barton CountyLocation X

Rig up _____

Drilling and Remarks:
*

RECORD

Cased _____ in., _____ ft.

Sand _____

Gas _____

Oil _____

Total Depth _____

PRODUCTION

1st 24 hrs. Nat. _____

1st 24 hrs. after shot _____

Gas _____ Cu. Ft.

Dry Hole _____

Abandoned _____

Date

JAN 25 1950 19J E. TYRA Scout

Kansas

Cheyenne View

Map No. _____ Sec. 11 Twp. 19 R. 12WWell No. 1 PanningLion Oil Company

Contractor _____

SE SE NE

E1. 1817
SECTION PLAT

_____ Ft. from N. Line

330 Ft. from S. Line330 Ft. from E. Line

_____ Ft. from W. Line

COMPLETE			o

Barton County

Location _____

Rig up _____

Drilling and Remarks:

8" @ 2485" @ 3400Lans 3110Conv 3371orb 3399Plugback to 3125

RECORD

Cased _____ in., _____ ft.

Sand _____

Gas _____

Oil _____

Total Depth 3406

PRODUCTION

1st 24 hrs. Nat. _____

1st 24 hrs. after shot _____

Gas _____ Cu. Ft.

Dry Hole _____

Abandoned _____

Date


24/3110-14

MAR 15 1950

19

J. E. TYRÄ Scout

SECTION PLAN

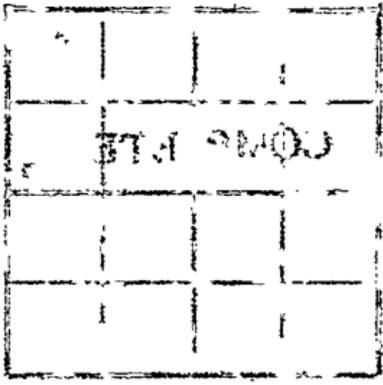

From the East
 From the West
 From the North
 From the South

RECORD

1. Scout Cards
 2. Land Small Map
 3. Land Wall Map
 4. Tracings
 5. France Map
 6. Pierce Map
 7. Misc.

MAR 21 1950

Scout Cards	6
Land Small Map	1
Land Wall Map	3
Tracings	4
France Map	1
Pierce Map	1
Misc.	1