

Section 11 Township 19 Range 12WWell No. #2 AchatzCompany Aladdin & Crowe

NORTH

						0	

SOUTH

WEST

EAST

Barton

KANSAS

12W

Sec. 11 Twp. 19 R. 12W

Well No. #2 Achatz Farm

Aladdin & Crowe

Company

Crowe Drlg. - Contr.

Contractor

Cheyenne View Pool


NORTH

230' Ft. from N. Line

Ft. from S. Line

990' Ft. from E. Line

Ft. from W. Line

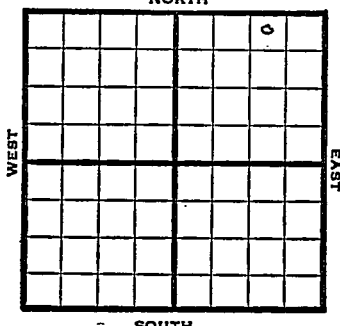

NW NE NE

1950

Elev 1804'

REPORT

11/22

Spud 11-14-50
8-5/8" @ 241'
Anhy 625-50'
Drlg. 2754'

1951

1/17

Spud 11-14-50
8 5/8" @ 241
Anhy 625-50 Lans 3105
DST 3107-75 opn 1 hr rec 25' mud
DST 3235-85 opn 1 hr rec 570' water
Arb 3298
5" @ 3417
TD 3761
36/3140-52 24/3110-27
24/3094-3102
1000 A
Comp 120 bopd
Completed

COMPLETED

County Barton State KansasSec. 11 (Blk.) 19 (Sur.) 12W Map No.Operator Aladdin & CroweWell No. 2 Farm AchatzElev. 1804 Location NW NE NE

						0

230 Ft. From N Line NE990 Ft. From E Line QuarterIst. ReportCompletion JAN 17 1954Remarks Cheyenne View PoolCrowe Drlg. - Contr.Spudding Date 11-14-50Drlg. Data Oil well TD 37618 5/8" @ 241 Any 625-50 Lans. 3105DST 3107-75 open 1 hr. Rec. 25' mudDST 3235-85 open 1 hr. Rec. 570' waterArb. 3298 5" @ 3417 TD 376136/ 3140-52 24/ 3119-27 24/ 3094-31021000 A Comp. 120 bopd