


Section 11 Township 19 Range 12-W

Well No. #2 Miller

Company Dozier Oil

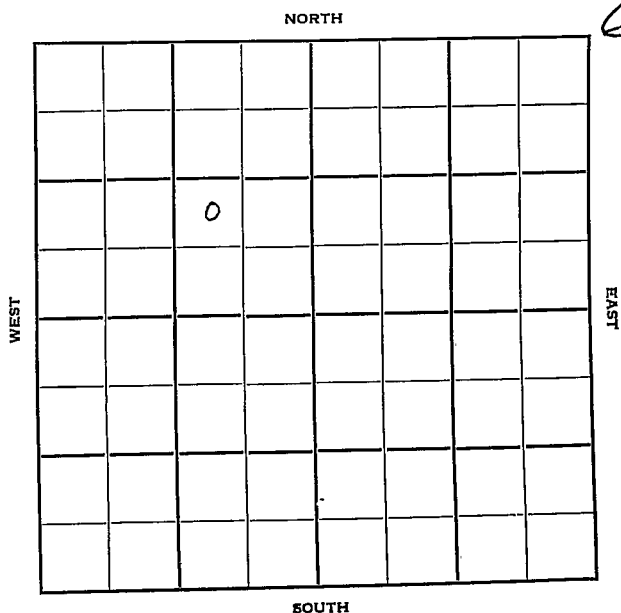

Barton

Sec. 11 Twp. 19 R. 12W

Well No. #2 Miller Farm

Dozier Oil Company

Lewis Drlg. Contractor

Cheyenne View


 Ft. from N. Line

990' Ft. from S. Line

990' Ft. from E. Line

 Ft. from W. Line

NW SE NW

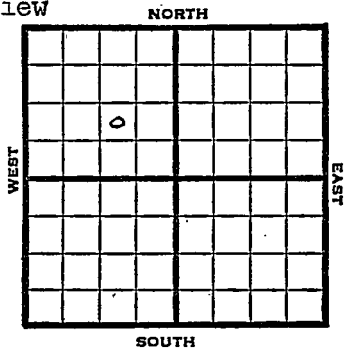

1950

Elev 1822

REPORT

6/21

Spud 6-17-50
8" @ 176'
Drlg. 1168'

8/2

8" @ 176
Top. 2732
SSO 2740-47
Heeb 2993 Toronto 3013
Br lime 3106 Lans 3124
DST 3210-26 opn 1 hr rec 10' mud
SSO, DST 3250-3330 opn 1 hr rec 75' ocm
60' wtr
Cong 3392
DST 3393-3405, opn 1 hr rec 10' mud
TD 3416
5" @ 3405, 12/3350-54, 9/3366-69
SP 3315, 48/3281-96, 1000A
S/7 bfph 95% wtr
SP 3275 12/3269-73, wtr
PB 3220 12/3187-91 1000A
all wtr Sq off. 12/3281-85 500A
SP 3180
12/3171-75 500A
B/3¹/₂ bwph 12/3136-46, 12/3120-24
D&A

ABANDONED

Map No. _____ Sec. 11 Twp. 19 R. 12W

Well No. 2 Miller

Dozier Oil Company

Lewis Drlg. Contractor

NW SE NW


_____ Ft. from N. Line

990 Ft. from S. Line

990 Ft. from E. Line

_____ Ft. from W. Line

SECTION PLAT

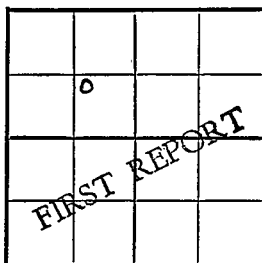

Barton County

Location _____

Rig up _____

Drilling and Remarks:

Spud 6-17-50

8" @ 176

drlg. 1168

RECORD

Cased _____ in., _____ ft.

Sand _____

Gas _____

Oil _____

Total Depth _____

PRODUCTION

1st 24 hrs. Nat. _____

1st 24 hrs. after shot _____

Gas _____ Cu. Ft.

Dry Hole _____

Abandoned _____


Date

JUN 21 1950 19

J. E. TYRA

Scout

SECTION FIVE

 

...
 ...
 ...
 ...

INDEX

JUN 23 1950

Scout Cards	
Land Small Map	
Land Wall Map	
Tracings	
France Map	
Pierce Map	
Misc.	

U.S.G.

Scout Cards	7 W
Land Small Map	
Land Wall Map	3
Tracings	
France Map	
Pierce Map	
Misc	

AUG 7 1960