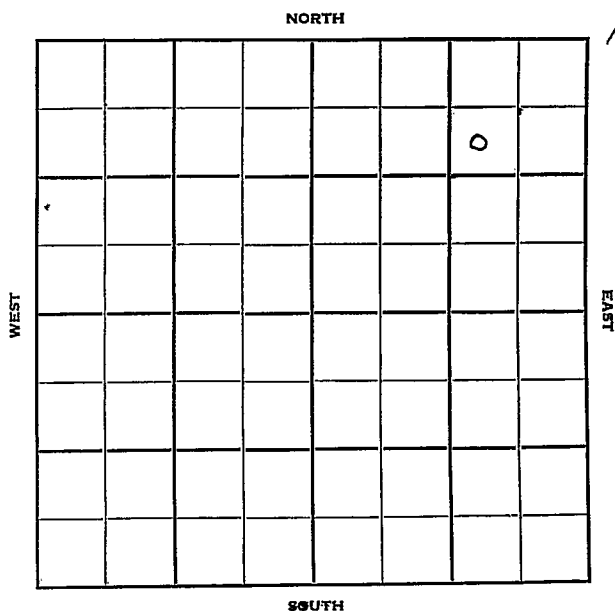


Section 11 Township 19 Range 12WWell No. 3 AchatzCompany Aladdin & Crowe

Barton

KANSAS

Sec. 11 Twp. 19 R. 12 WWell No. # 3 Achatz FarmAladdin & Crowe CompanyCrowe Drlg. Contractor

Cheyenne View


990 Ft. from N. Line

Ft. from S. Line

990 Ft. from E. Line

Ft. from W. Line

SW NE NE

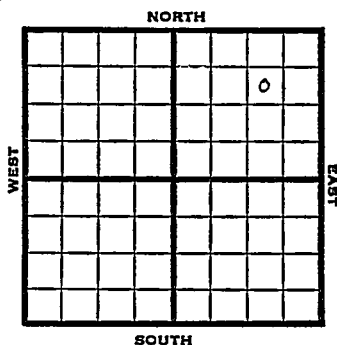

1951

Elev. 1811' REPORT

7/18

Spud 7-8-51

8" @ 268' Anhy 640' Heeb 2958'

Br Li. 3072' Lans. 3087'

Drlg. 3120'

8/15

Spud 7-8-51

Oil well TD 3404' 8" @ 268'

Anhy 640' Heeb 2958' Br. lime 3072'

Lans. 3087'

DST 3091-3162 open $\frac{1}{2}$ hr. rec 1000'
oil & OCMDST 3211-71 open $\frac{1}{2}$ hr. rec 840' oil,
90' SW

Anb. 3388-90 5" @ 3388' CO to 3404'

1000 A S/1 BOPH 18% oil PB 3345'

36/3234-46 1000 A S/20 BOPH

8 hr. 1500 A S/10 BOPH PB 3190'


24/3133-41 36/3118-30 24/3104-12

36/3080-92 2000 A F/50 BOPH

Comp. BHB 1545 BOPD

COMPLETED

County Barton State Kansas
 Sec. 11 (Blk. 19 (Sur. 12W Map No.
 (Twp.) (Rge.)
 Operator Aladdin & Crowe
 Well No. 3 Farm Achatz
 Elev. Location SW NE NE

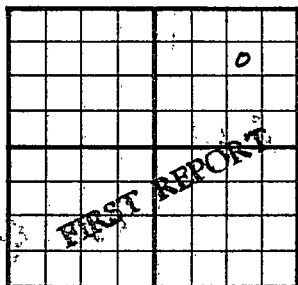

990 Ft. From N Line NE
 990 Ft. From E Line Quarter
 Ist. Report JUL 1 8 1951
 Completion
 Remarks
Crowe Drlg. - Contr.
 Spudding Date 7-8-51

Drlg. Data Cheyenne View - pool
8" @ 268 Anhy 640 Neel 29.58
Br l. 3072 Lane. 3087 ϕ 3120

Scout Cards *mm*

Land Small Map

Land Wall Map

Tracings

France Map

Pierce Map

Misc.

JUL 23 1951

Drig. Data



J. E. TYRA

Scout Cards *mm*

Land Small Map

Land Wall Map *5*

Tracings

France Map

Pierce Map

Misc.

AUG 27 1951

Orig. Data