


Section 11 Township 19 Range 12-W

Well No. #3 Ahrens

Company Aladdin & Crowe

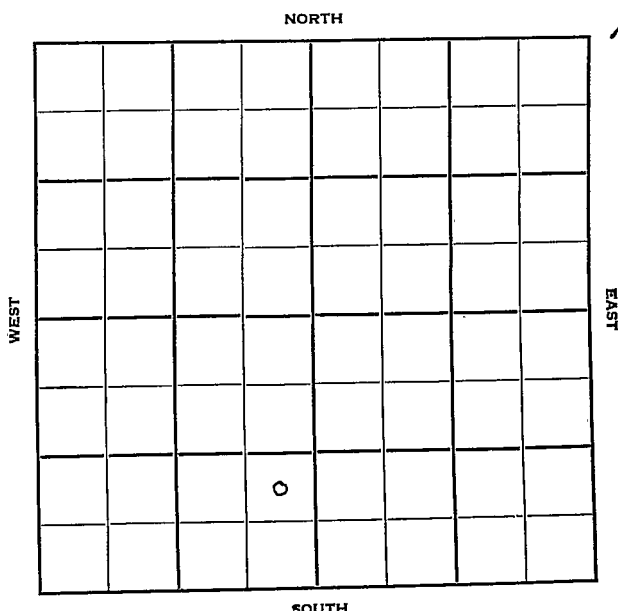

Sec. 11 Twp. 19 R. 12-W

Well No. #3 Ahrens Farm

Aladdin & Crewe Company

Cheyenne View Contractor


 Ft. from N. Line

990 Ft. from S. Line

330 Ft. from E. Line

 Ft. from W. Line

NE SE SW

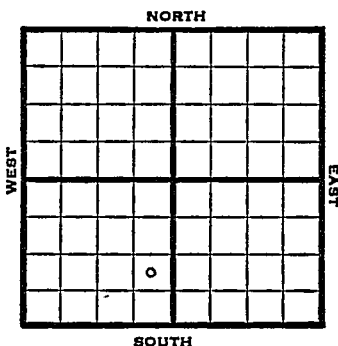

1950 Elev 1835 REPORT

6/7 Spud 6-2-50
8" @ 244
Anhy 660-75
Drlg 1845
7/19 8" @ 244
Anhy 660-75 Lans 3126
DST 3128-96, opn 15 min rec 540' oil
& mud
Arb 3380-85
5" @ 3390
20/3194-3201
S/5-6 bwph
sq perf
24/3174-82, 20/3167-74, 24/3148-56,
12/3144-48, 12/3131-35, 24/3124-31
3000 acid
F/50 boph
Comp 526 bopd
TD 3385
Completed

COMPLETED

Kansas

Map No. _____ Sec. 11 Twp. 19 R. 12WWell No. 3 AhrensAladdin & Crowe Company_____
Contractor

NE SE SW

SECTION PLAT

Ft. from N. Line990 Ft. from S. Line330 Ft. from E. Line_____
Ft. from W. Line

FIRST REPORT

Barton

Location _____

Rig up _____

Drilling and Remarks:

Spud 6-2-50

8" @ 244

Anhy 66C-75

Drlg. 1845

RECORD

Cased _____ in., _____ ft.

Sand _____

Gas _____

Oil _____

Total Depth _____

PRODUCTION

1st 24 hrs. Nat. _____

1st 24 hrs. after shot _____

Gas _____ Cu. Ft.

Dry Hole _____

Abandoned _____

Date

JUN 7

1950

J. E. TYRA

Scout

JUN 12 1950

Scout Cards	SW
Land Small Map	
Land Wall Map	3
Tracings	
France Map	
Pierce Map	
Misc.	

Kansas

Map No. _____ Sec. 11 Twp. 19 R. 12WWell No. 3 AhrensAladdin & Crowe

Company

Contractor


NE SE SW

E1. 1835
SECTION PLAT

_____ Ft. from N. Line

990 Ft. from S. Line330 Ft. from E. Line

_____ Ft. from W. Line

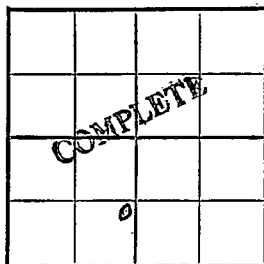Barton County

Location _____

Rig'up _____

Drilling and Remarks:

8" @ 244-Anhy 660-75Lans. 3126DST 3128-96open-15 min.Rec. 540' oil & mudArb. 3380-85

RECORD

Cased _____ in., _____ ft.

Sand _____

Gas _____

Oil _____

Total Depth 3385

PRODUCTION

1st 24 hrs. Nat. _____

1st 24 hrs. after shot _____

Gas _____ Cu. Ft.

Dry Hole _____

Abandoned _____


Date

JUL 19 1950

19

J. E. TYRA Scout

AL 107 C

 

comp. 526 bopd

12/ 3131-35

24/ 3148-56

20/ 3167-74










sq. per

S/ 5-6 bopd

20/ 3194-3201

5" @ 3390

AUG 1961

Scout Cards	7 w
Land Small Map	
Land Wall Map	
Tracings	
France Map	
Pierce Map	
Misc.	