


FORM 51 25M 3-49 PETROL Barton

Section 11 Township 19 Range 12W

Well No. #3 Hammeke

Company Lion Oil

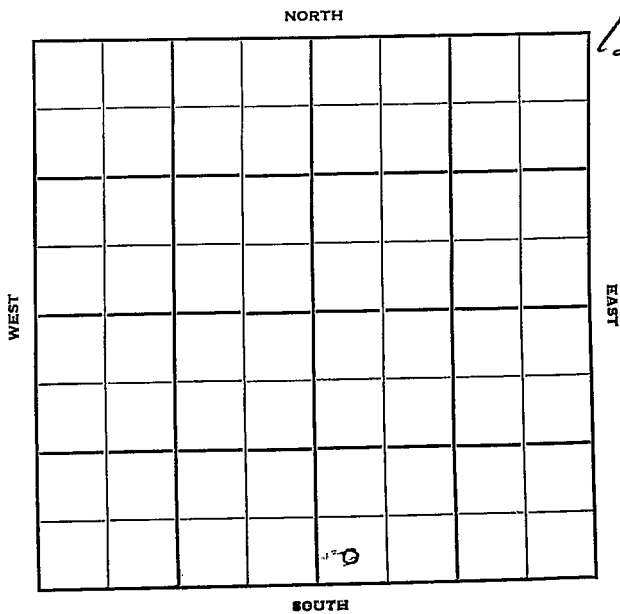

Barton

KANSAS

Sec. 11 Twp. 19 R. 12 W

Well No. # 3 Hammeke Farm

Lion Oil Company

Garvey Oil Contractor

Cheyenne View Pool


 Ft. from N. Line

330 Ft. from S. Line

 Ft. from E. Line

330 Ft. from W. Line

SW SW SE

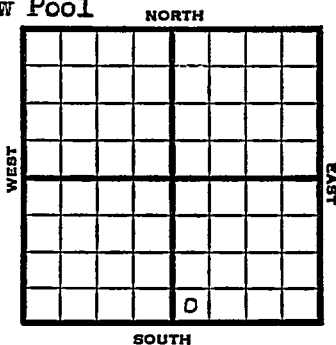

1951

Elev. 1836' REPORT

8/8

Spud 8-3-51
8" @ 257'
Drlg. 2420'

8/15

Spud 8-3-51
D & A TD 3425' 8" @ 257'
Heeb 2994' Br. lime 3109'
KC 3125'
DST 3130-3200 open 1 hr. rec 42' SW &
mud w/VSSO
DST 3261-3332 open 1 hr. rec 100' SGCM
Cong. 3377' Arb. 3395'
DST 3399-3425 open 15 min. rec 10' mud
TD 3425' D & A

ABANDONED

Scout Cards <u>mm</u>	AUG 14 1951
Land Small Map	
Land Wall Map <u>33</u>	
Tracings	
France Map	
Pierce Map	
MISC.	

Orig. Date

Scout Cards *m.m.*
Land Small Map
Land Wall Map
Tracings
France Map
Pierce Map
Misc.

AUG 27 1951