

Section 11 Township 19 Range 12-W

Well No. #3 Panning

Company Lion Oil

NORTH

WEST

EAST

							0

SOUTH

*S*

Sec. 11 Twp. 19 R. 12W

Well No. #3 Panning Farm

Lion Oil Company


Cheyenne View Pool Contractor

Ft. from N. Line

NORTH

990' Ft. from S. Line

330' Ft. from E. Line

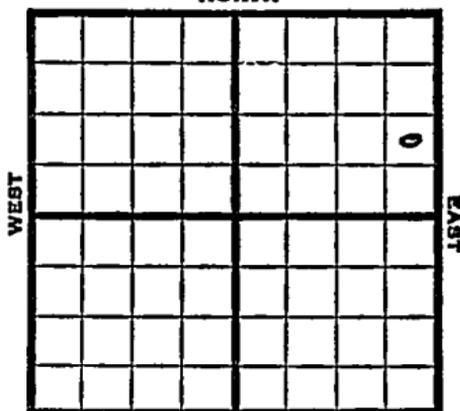

Ft. from W. Line

NE SE NE

1951 Elev. 1808' REPORT

1/10 Location  
2/7 Spud 1-12-51  
Oil Well TD 3421  
8" @ 205' Br Lime 3075  
Lans. 3093'  
DST 3098-3165 opn 1/2 hr Rec. 190'  
hocm, gas in 29 min.  
Cong. 3359' Arb. 3393-98'  
5" @ 3393 TD 3421  
Rec. wtr SP 3350  
12/3222-26 21/3230-37 21/3247-54  
30/3264-74 36/3286-98 2000 A wtr  
SP 3155 24/3134-42 110/3093-3130  
2000 A F/85 boph F/24 boph  
Comp. 896 bopd.

COMPLETED



JAN 12 1951

Scout Cards	.....
Land Small Map	.....
Land Wall Map	.....
Tracings	.....
France Map	.....
Piercé Map	.....
Misc.	.....



Scout Cards

Land Small Map

Land Wall Map

Tracings

France Map

Pierce Map

Misc.

FEB 9

1954

Drig. Data