


Section 11 Township 19 Range 12 W

Well No. # 4 Kultgen "B"

Company Aladdin Pet.

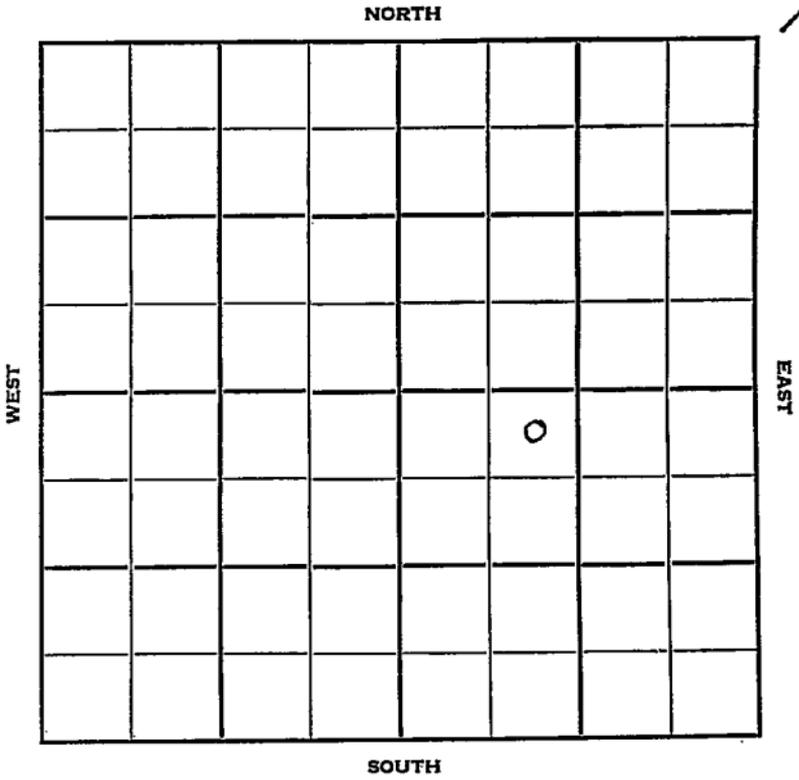

Sec. 11 Twp. 19 R. 12W

Well No. #4 Kultgen "B" Farm

Aladdin Pet. Company

Contractor

Cheyenne View Pool


330' Ft. from N. Line

_____ Ft. from S. Line

_____ Ft. from E. Line

990' Ft. from W. Line

NE NW SE

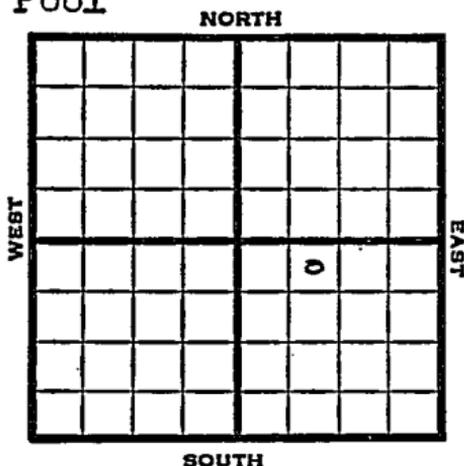

1951 Elev. 1832' REPORT

5/29 Spud 5-27-51
8" @ 240
Drlg. 355'

6/13 Spud 5-27-51
D & A TD 3440' 8" @ 240
KC 3115' Heeb 2984' Br. lime 3099'
DST 3243-3360' open 1/2 hr. rec 30' mud
Cong. 3365' Arb. 3415-40 TD
D & A

ABANDONED

Scout Cards
Land Small Map
Land Wall Map
Tracings
France Map
Pierce Map
Misc.

MAR 2 1951

Scout Cards	<i>mm</i>
Land Small Map
Land Wall Map	<i>35</i>
Tracings
France Map
Pierce Map
Misc.

JUN 18 1961

Drig. Data