


Section 11 Township 19 Range 12-W

Well No. #5 Ahrens

Company Aladdin & Crowe

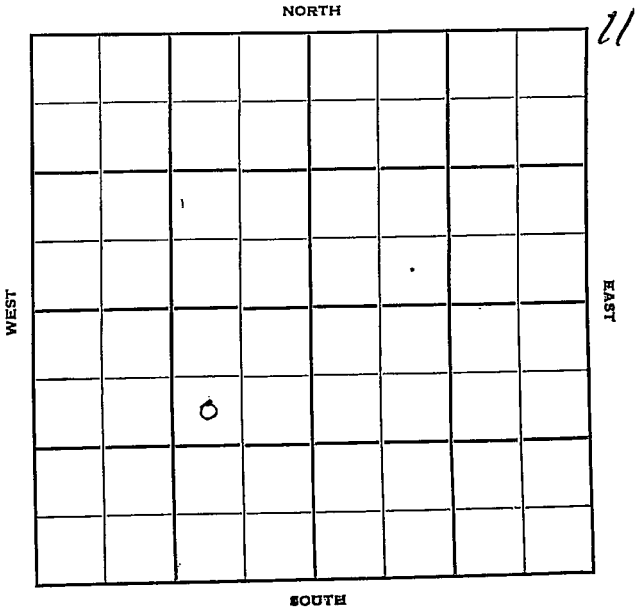

KANSAS
19

Barton
12-W

Sec. 11 Twp. _____ R. _____

Well No. #5 Ahrens Farm _____

Aladdin & Crowe Company _____

Crowe Drlg. Contractor _____

Cheyenne View


990 Ft. from N. Line

_____ Ft. from S. Line

990 Ft. from E. Line

_____ Ft. from W. Line

SW NE SW

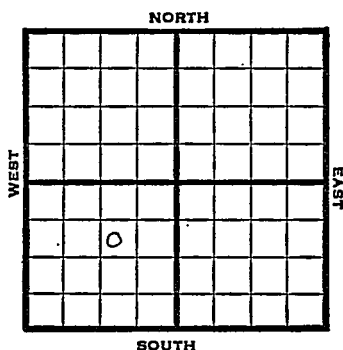

1950 Elev 1834 REPORT

10/4 MIR

11/22 Spud 10-4-50
8 5/8" @ 237
Anhy 655-82
Heeb 2985
Br lime 3099
Lans 3115
DST 3117-87 opn 15 min Rec 600' O&GCM
Cong 3377 Arb 3380-87
5" @ 3384
TD 3416
1000 A
S/2 1/2 boph
2000 A
S/4 boph
Comp 128 bopd 5% water
Completed

COMPLETED

County Barton State Kansas

Sec. 11 (Blk. Twp.) 19 (Sur. Rge.) 12W Map No.

Operator Aladdin & Crowe

Well No. 5 Farm Ahrens

Elev. 1834 Location SW NE SW

990 Ft. From N Line SW

990 Ft. From E Line Quarter

1st. Report OCT 4 1950

Completion _____

Remarks _____

Crowe Drlg. - Contr.

Spudding Date _____

Drlg. Data Cheyenne View Pool

M I R

J. E. TYRA

