


Section 11 Township 19 Range 12W

KANSAS

Well No. #6 Ahrens

Company Aladdin & Crowe Drlg.

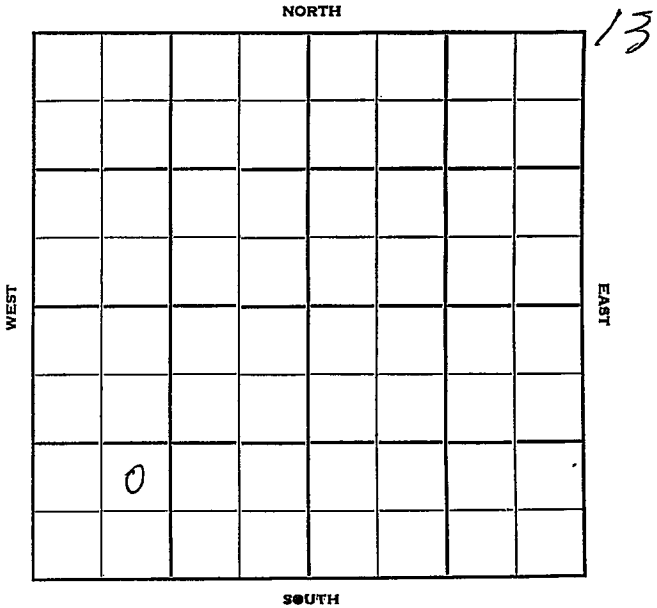

Barton

KANSAS

Sec. 11 Twp. 19 R. 12W

Well No. #6 Ahrens Farm

Aladdin & Crowe Drlg. Company

Crowe Drlg. - Contr. Contractor

Cheyenne View Pool


 Ft. from N. Line

990' Ft. from S. Line

 Ft. from E. Line

990' Ft. from W. Line

NE SW SW

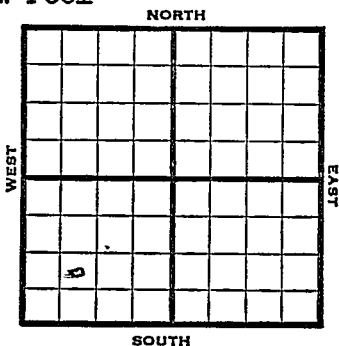

1950.

Elev. 1836' REPORT

11/29

Location

12/27

Spud 11-25-50

D&A TD 3442

8" @ 238

Heeb. 3009 Br. Lime 3124

KC 3141

DST 3143-3216 opn 1 1/4 hr

Rec. 90' mud DST 3230-60

opn 1 hr Rec. 130' mud & wtr

Cong. 3407 TD 3442'

D&A

ABANDONED

