


Section 11 Township 19 Range 12 W

Well No. # 5 Panning

Company Lion Oil

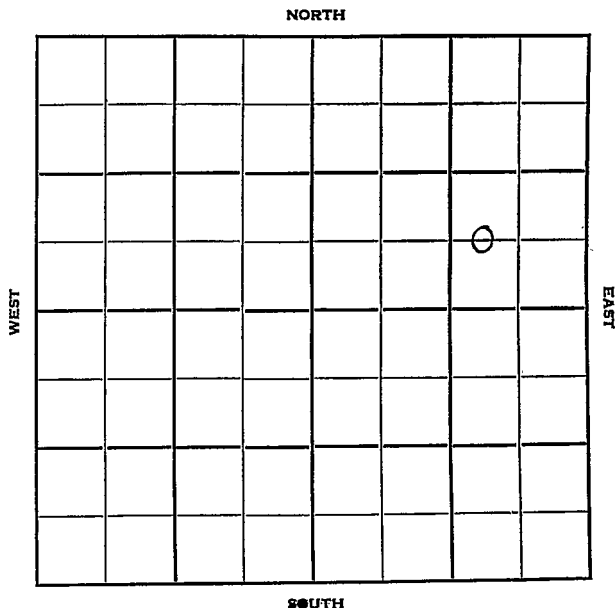

Barton

KANSAS

Sec. 11 Twp. 19 R. 12 W

Well No. # 5 Panning Farm

Lion Oil Company

Rine Drlg. Contractor


Cheyenne View Pool

\_\_\_\_\_ Ft. from N. Line

660 Ft. from S. Line

990 Ft. from E. Line

\_\_\_\_\_ Ft. from W. Line

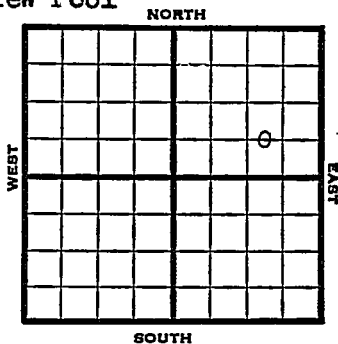

C W L S E N E

1951

Elev. 1827' REPORT

5/2

8" @ 198  
Drlg. 1680'

5/23

Oil Well TD 3401  
8" @ 198  
Br Line 3093' Lans. 3108'  
DST 3110-78 opn 15 min.  
Rec. 255' ho & gcm  
Arb. 3368-72 5" @ 3369  
TD 3398 B/1/2 boph DD 3401  
S/7 goph 1000 A  
S/1 boph 2000 A S/16 boph  
Comp. 510 bopd

**COMPLETE**

County Barton State Kansas

Sec. 11 (Blk. 19) (Sur. Rge.) 12W Map No.

Operator Lion Oil

Well No. 5 Farm Panning

Elev. Location C W I. SE NE


**FIRST REPORT**

660 Ft. From S Line NE

990 Ft. From E Line Quarter

1st. Report MAY 2 1951

Completion

Remarks

Rine Drlg. - Contr.

Spudding Date

\*Drlg. Data Cheyenne View Pool

8" @ 198 drlg. 1680

J. E. TYRA

County Barton State Kansas  
 Sec. 11 (Blk. Twp.) 19 (Sur. Rge.) 12W Map No.  
 Operator Lion Oil  
 Well No. 5 Farm Panning  
 Elev. 1827 Location C W L SE NE


COMPLETE

660 Ft. From S Line NE  
990 Ft. From E Line Quarter  
 1st. Report  
 Completion MAY 23 1951  
 Remarks Cheyenne View Pool  
Rine Drlg. - Contr.  
 Spudding Date

Drlg. Data Oil well TD 3401  
8" @ 198 Br. lime 3093 Lans. 3108  
DST 3110-78 open 15 min. Rec. 255' ho  
& gcm Arb. 3368-72 5" @ 3369 TD 3398  
B/ 1/2 boph DD. 3401 S/ 7 goph 1000 A  
S/ 1 boph 2000 A. S/ 1.6 boph  
Comp. 510 bopd

J. E. TYRA