


Section 11 Township 19 Range 12 W

Well No. # 7 Panning

Company Lien Oil

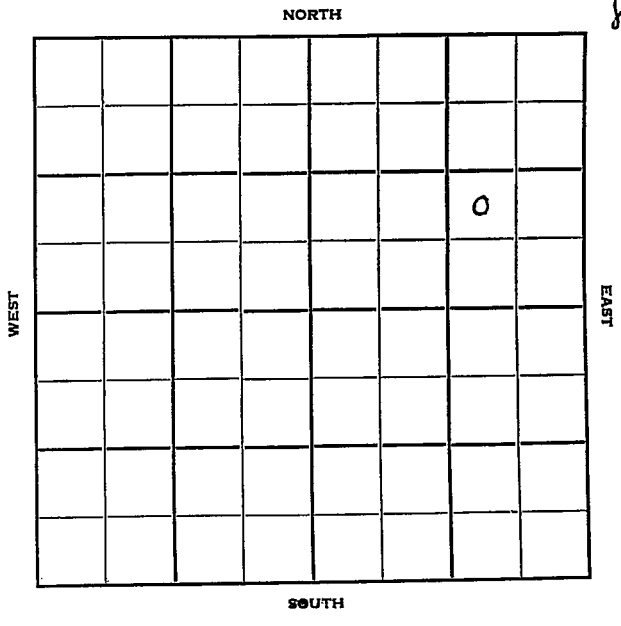

Barton

KANSAS

Sec. 11 Twp. 19 R. 12 W

Well No. # 7 Panning Farm

Lion Oil Company

Rine Drlg. Contractor


Cheyenne View Pool

 Ft. from N. Line

990 Ft. from S. Line

990 Ft. from E. Line

 Ft. from W. Line

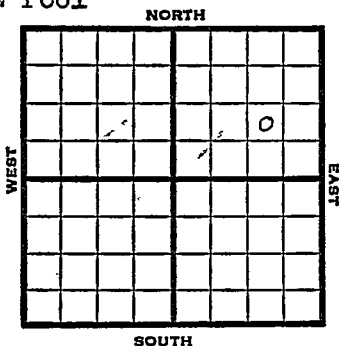

NW SE NE

1951 ~~Rev.~~ 1825' REPORT

5/16 Location

6/27 Spud 5-30-51
 Oil well TD 3378' 9" @ 200'
 Heeb 2968' Br. line 3083'
 Lans. 3098' Arb. 3371-78'
 5" @ 3372' CO to 3341' 2 1/4 / 3296-3304
 1000 A SP 3285' 2 1/4 / 3258-66'
 2 1/4 / 3272-80 2000 A S/2 BOPH
 SP 3185' 15 / 3170-75 1/2 BO
 15 / 3145-50 inc. oil 42 / 3120-33
 inc. oil S / 6 1/2 BO 1 1/2 hr. 2000 A
 F / 40 BOPH
 Comp. 1391 BOPD

COMPLETED

County Barton State Kansas

Sec. 11 (Blk. 19) (Sur. Rge.) 12W Map No.

Operator Lion Oil

Well No. 7 Farm Panning

Elev. 1825 Location NW SE NE

990 Ft. From S Line NE

990 Ft. From E Line Quarter

1st. Report

Completion JUN 27 1951

Remarks Cheyenne View Pool

Rine Drlg. - Contr.

Spudding Date 5-30-51

Drlg. Data Oil well TD 3378

9" @ 200 Heeb. 2968 Br. line 3083

Lans. 3098 Arb. 3371-78 5" @ 3372

CO to 3341 24/ 3296-3304 1000 A

SP 3285 24/ 3258-66 24/ 3272-80

2000 A S/ 2 boph SP 3185 15/ 3170-75

1/2 bo 15/ 3145-50 inc. oil 42/ 3120-33

inc. oil S/ 6 1/2 bo 1 1/2 hr. 2000 A

F/ 40 boph Comp. 1391 bopd

J. E. TYRA