


Section 11 Township 19 Range 12 W

Well No. # 7 Ahrens

Company Aladdin Pet.

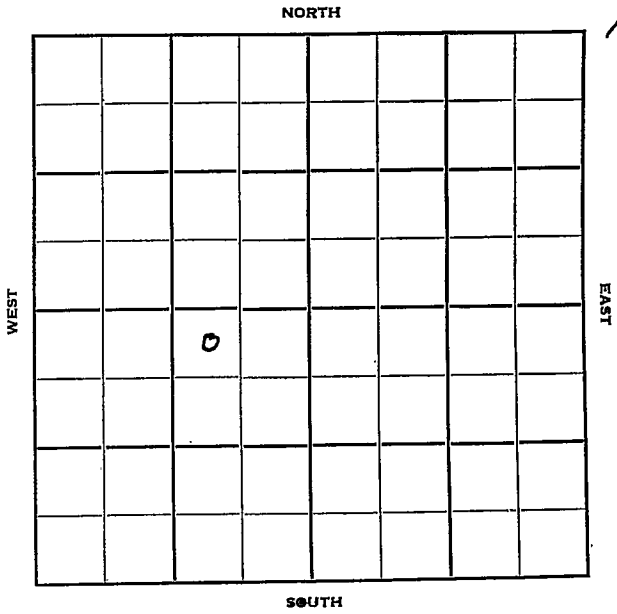

Barton KANSAS

Sec. 11 Twp. 19 R. 12 W

Well No. # 7 Ahrens Farm

Alladdin Pet. Company

Crowe Drlg. Contractor

**Cheyenne View Pool**


330 Ft. from N. Line

\_\_\_\_\_ Ft. from S. Line

990 Ft. from E. Line

\_\_\_\_\_ Ft. from W. Line

NW NE SW

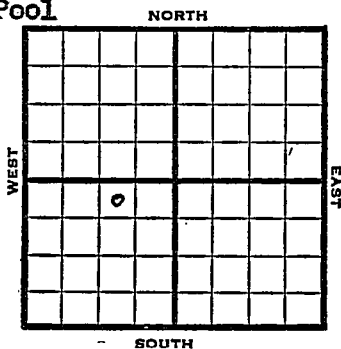

1951 Elev. 1831' REPORT

2/28 Spud 2-24-51  
8" @ 245' Anhy 640'  
Drlg. 1475

3/28 Spud 2-24-51  
Oil Well TD 3425  
8" @ 245 Anhy 640'  
Top 2937' Heeb. 2980  
Br Lime 3094  
Lans 3111'  
DST 3118-83 opn 1/2 hr Rec. 90' gcm  
SSO  
DST 3236-90 opn 1 hr Rec. 90' socm  
Arb. 3404-05 5" @ 3404  
TD 3425 S/2 1/2 bfph 50% wtr SP 3356  
85/3259-88 22/3242-50 2000 A  
S/130 bopd Comp. 111 bopd 9% wtr

**COMPLETED**



