

Section 11 Township 19 Range 12 W

Well No. # 8 Ahrens

Company Aladdin & Crowe

NORTH

14

WEST

EAST

SOUTH

0

Sec. 11 Twp. 19 R. 12W

Well No. #8 Ahrens Farm

Aladdin & Crowe Company

Grove - Contr. Contractor

Cheyenne View Pool


_____ Ft. from N. Line

330' Ft. from S. Line

330' Ft. from E. Line

_____ Ft. from W. Line

SE SE SW

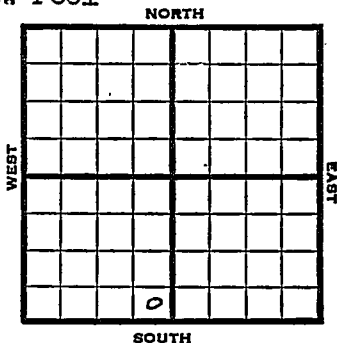

1951 Elev. 1836' REPORT

7/3 Spud 6-26-51
8" @ 237
Anhy 660
Drlg. 2384'

7/25 Spud 6-26-51 Oil well TD 3416'
8" @ 237 Anhy 660' Lans. 3130'
DST 3132-3202' open 45 min. rec 145'
O & GCM, 600' gas
DST 3252-3322' open 45 min. rec 255' HC
& GCM, 1850' gas Rearb. 3387'
Arb. 3395-3401' 5" @ 3399'
TD 3416' 1000 A 3 BWPB
PB 3350' 24/3319-27 1000 A
S/1½ BOPB SP 3310' 48/3288-3304
35/3272-84 24/3258-66 2000 A
S/30 BOPB
Comp. 148 BOPD 6% water

COMPLETED

