


Section 11 Township 19 Range 11W

Well No. #1 Brenn

Company E. H. Adair

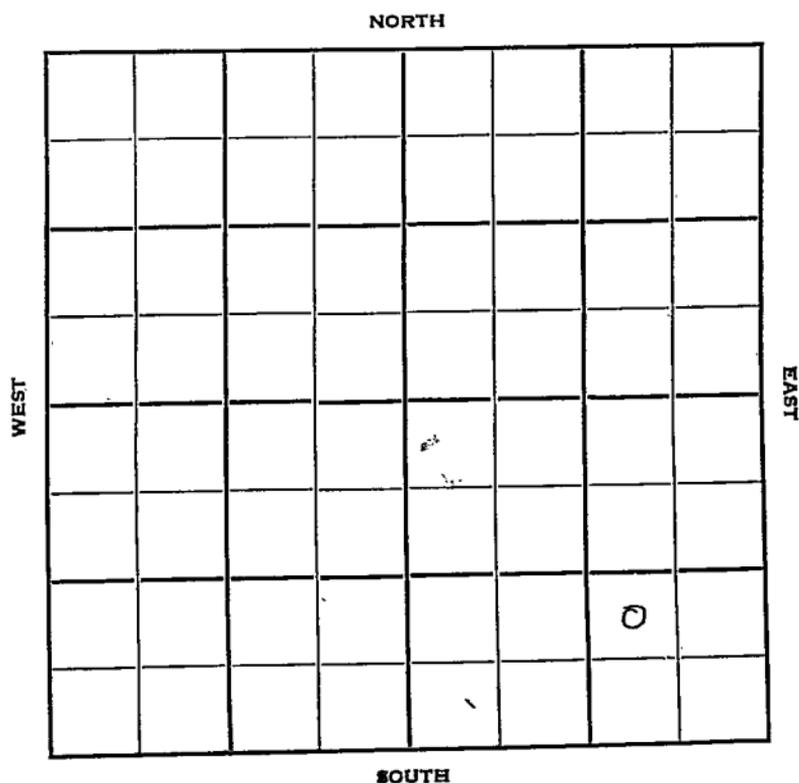

Sec. 11 Twp. 19 R. 11W ✓

Well No. #1 Brenn Farm

E. H. Adair Company

Rick Pool Contractor


_____ Ft. from N. Line

990' Ft. from S. Line

990' Ft. from E. Line

_____ Ft. from W. Line

NW SE SE

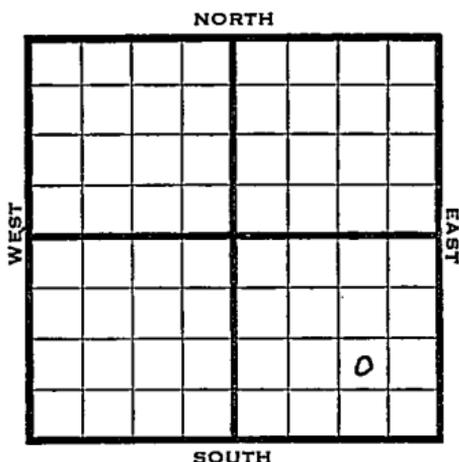

1950 Elev. 1777' REPORT

4/19 Cellar & Pits.

5/31 8" @ 242'
Anhy 540-60
Heeb 2907
Br. Lime 3028'
Lans. 3045
SO 3049-51
3072-73
3081-82
3112-14
Arb. 3327-37
5" @ 3329'
TD 3342'
48/3328-44
1000 A
Swab 4 BOPH
Comp. 60 BOPD

COMPLETED

Map No. _____ Sec. 11 Twp. 19 R. 11WWell No. 1 BrennE. H. Adair Company

Contractor

NW SE SE

_____ Ft. from N. Line

990 Ft. from S. Line990 Ft. from E. Line

_____ Ft. from W. Line

SECTION PLAT

Barton County

Location _____

Rig up _____

Drilling and Remarks:

Cellar & pits

RECORD

Cased _____ in., _____ ft.

Sand _____

Gas _____

Oil _____

Total Depth _____

PRODUCTION

1st 24 hrs. Nat. _____

1st 24 hrs. after shot _____

Gas _____ Cu. Ft.

Dry Hole _____

Abandoned _____

Date

APR 19 1950 19J. E. TYRA Scout

Rick Pool

Form 26 200 Bks. 11-49 Petrol

Kansas

Map No. _____ Sec. 11 Twp. 19 R. 11W

Well No. 1 Brenn

E. H. Adair Company

Contractor

NW SE SE


E1.1777
SECTION PLAT

_____ Ft. from N. Line

990 Ft. from S. Line

990 Ft. from E. Line

_____ Ft. from W. Line

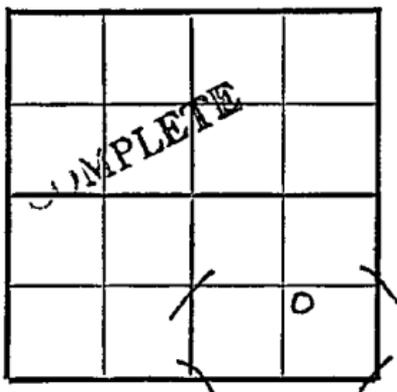

Barton

Location _____

Rig up _____

Drilling and Remarks:

8" c 242
 anky 540-60
 Heb. 2907
 Br. line 3028
 Lans. 3045
 SO 3049-51
 3072-73

RECORD

Cased _____ in., _____ ft.

Sand _____

Gas _____

Oil _____

Total Depth _____

PRODUCTION

1st 24 hrs. Nat. _____

1st 24 hrs. after shot _____

Gas _____ Cu. Ft.

Dry Hole _____

Abandoned _____

3081-82

Date 3112-14

MAY 31 1950 19

J. E. TYRRE Scout


UNITED STATES GOVERNMENT





 


APR 6 1950

RECORD


Scout Cards	
Land Small Map	
Land Wall Map	3
Tracings	
France Map	
Pierce Map	
Misc.	


1000 A
 48/3328-44
 3342
 5" x 3329
 3327-37

3327-37