

Barton

Section 11 Township 19 Range 15W

KANSAS

Well No. #2 Brenn

Company E. H. Adair

NORTH

WEST

EAST

SOUTH

Barton

KANSAS

Sec. 11 Twp. 19 R. 11W

Well No. #2 Brenn Farm

E. H. Adair Company

Adair - Contr. Contractor

Rick Pool

Ft. from N. Line

990'


Ft. from S. Line

Ft. from E. Line

990'

Ft. from W. Line

NORTH

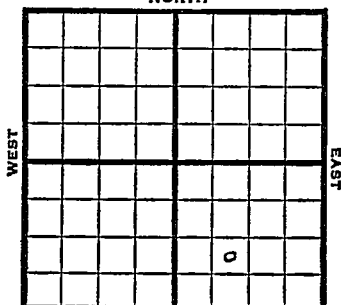

SOUTH

NE SW SE

1950

Elev. 1780' REPORT

11/22


Spud 11-16-50
8" @ 229'
Anhy 544-68'
Drlg. 2058'

1951

1/10

Spud 11-16-50
Oil Well TD 3362
8" @ 229 Anhy 544-68
Br Lime 3036 Lans. 3053
Cong. 3337 Arb. 3344-46
5" @ 3345 TD 3362 500 A
2500 A P/4 bw 3/4 boph
Comp. 25 bopd

COMPLETED

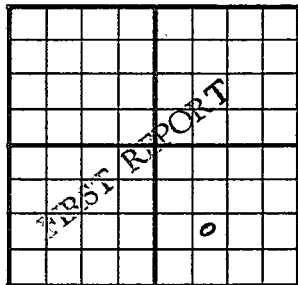County Barton State KansasSec. 11 (Blk.
Twp.) 19 (Sur.
Rge.) 11W Map No.Operator E. H. AdairWell No. 2 Farm BrennElev. Location NE SW SE990 Ft. From S Line SE990 Ft. From W Line Quarter1st. Report NOV 22 1950

Completion


Remarks

Adair - Contr.Spudding Date 11-16-50Drlg. Data Rick Pool8" @ 229 Anhy 544-68 drlg. 2058

Scout Cards	Nov 27 1950
Land Small Map	
Land Wall Map	
Tracings	
France Map	
Pierce Map	
Misc.	

Orig. Data

County Barton State Kansas
 Sec. 11 (Blk. Twp.) 19 (Sur. Rge.) 11W Map No. _____
 Operator E. H. Adair
 Well No. 2 Farm Brenn
 Elev. 1780 Location NE SW SE

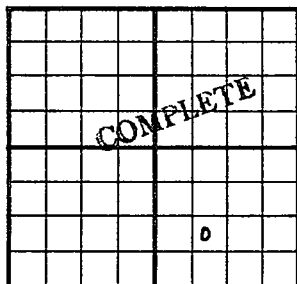

990 Ft. From S Line SE
990 Ft. From W Line Quarter
 1st. Report _____
 Completion JAN 10 1951
 Remarks Rick Pool
Adair - Contr.
 Spudding Date 11-16-50

Drlg. Data Oil well TD 3362
8" @ 229 Anhy 544-68 Br. lime 3036
Lans. 3053 Cong. 3337 Arb. 3344-46
5" @ 3345 TD 3362 500 A 2500 A
P/ & bw 3/4 boph Comp. 25 bopd

APR 19 1951

Scout Cards	
Land Small Map	
Land Wall Map	37
Tracings	
France Map	
Pierre Map	
Misc.	