


Section 11 Township 9 Range 11W

Well No. #1 Klöpfer

Company C. E. Ash & L. B. Smith

NORTH

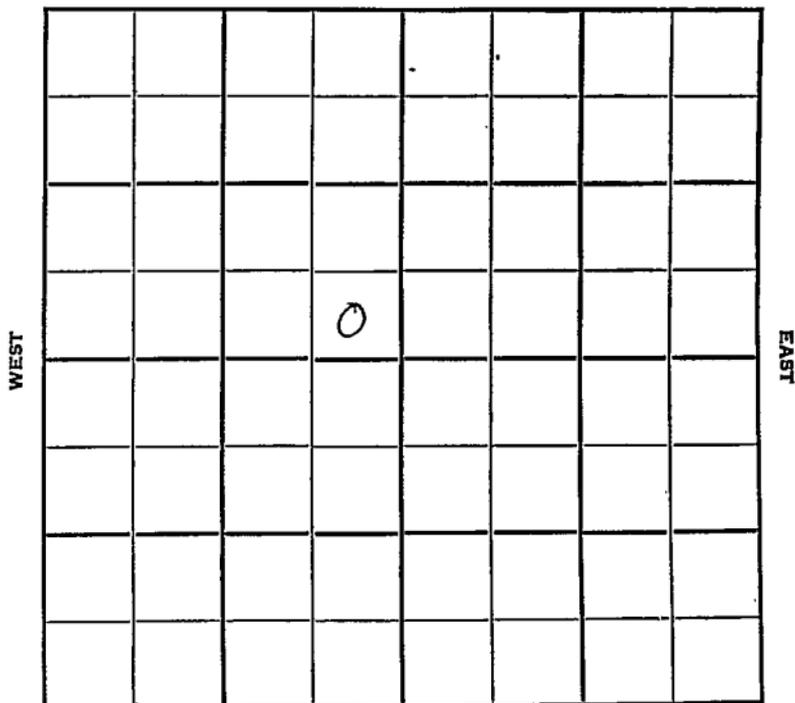

SOUTH

Sec. 11 Twp. 19 R. 11W

Well No. #1 Klepper Farm

C. E. Ash & L. B. Smith Company

Rick Pool Contractor


Ft. from N. Line

330' Ft. from S. Line

330' Ft. from E. Line

Ft. from W. Line

SE SE NW

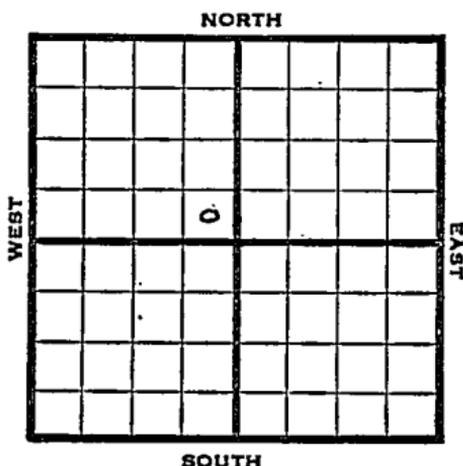

1950 Elev. 1758' REPORT

11/29 Spud 11-27-50

12/13 Spud 11-27-50
 D&A TD 3374
 8" @ 205' Anhy 525-555
 Top. 2633' Heeb. 2903
 Br Lime 3022 Lans. 3041
 Stain 3067-71 3121-48
 DST 3172-96 opn 1/2 hr Rec. 18' wtr
 & mud
 Cong. 3324 Ch. Cong. 3339
 Arb. 3364-74 TD
 D&A ABANDONED


County Barton State Kansas

Sec. 11 (^{Blk.}_{Twp.}) 19 (^{Sur.}_{Rge.}) 11W Map No.

Operator C. E. Ash & L. B. Smith

Well No. 1 Farm Klepper

Elev. _____ Location SE SE NW

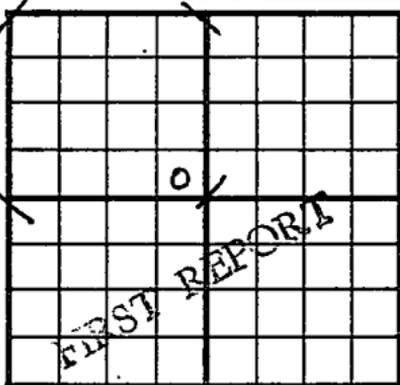

330 Ft. From S Line NW

330 Ft. From E Line Quarter

1st. Report NOV 29 1950

Completion

Remarks Sohio farmout

Spudding Date 11-27-50

Drilg. Data Rick Pool

J. E. TYRA

DEC 1 1938

Scout Cards	
Land Small Map	
Land Wall Map	3
Tracings	
France Map	
Pierce Map	
MISC.	

Orig. Data


County Barton State Kansas

Sec. 11 (Blk. 19) (Sur. 11W) (Twp. 11W) Map No.

Operator C. E. Ash & L. B. Smith

Well No. 1 Farm Klepper

Elev. 1758 Location SE SE NW

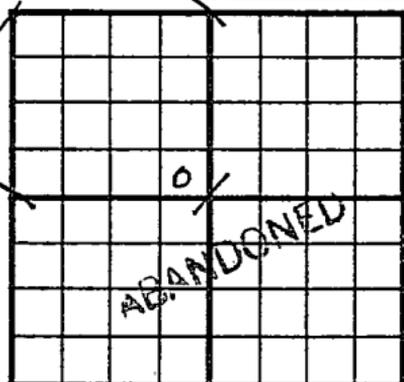

330 Ft. From S Line NW

330 Ft. From E Line Quarter

Ist. Report

Completion DEC 13 1950

Remarks Rick Pool

Spudding Date 11-27-50

Drlg. Data D & A TD 3374

8" @ 205 Anhy 525-555 Top. 2633

Heeb. 2903 Br. lime 3022 Lans. 3041

Stain 3067-71 3121-48 DST 3172-96

open $\frac{1}{2}$ hr. Rec. 18' water & mud

Cong. 3324 Ch. Cong. 3339 Arb. 3364-74TD

D & A

DEC 19 1950

Scout Cards	
Land Small Map	
Land Wall Map	
Tracings	
.....	
