


Section 11 Township 19 Range 11W


Well No. #2 Klepper

Company Mastin & Hyde

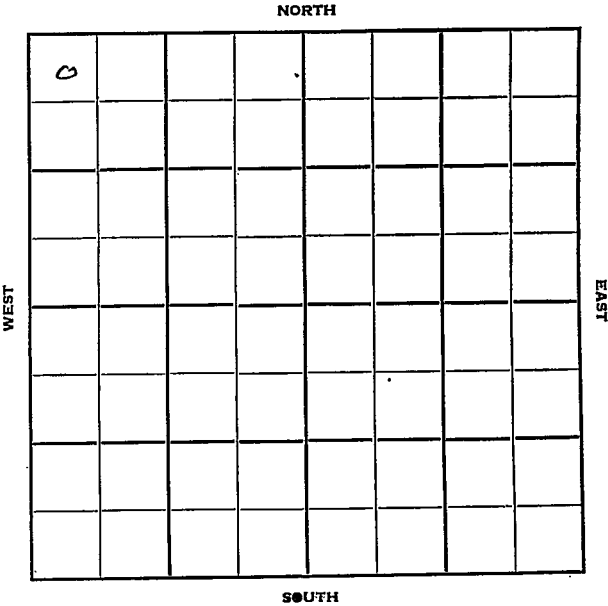

Sec. 11 Twp. 19 R. 11WWell No. #2 Klepper- FarmMastin & Hyde CompanyIsern ContractorKlepper330 Ft. from N. Line Ft. from S. Line Ft. from E. Line330 Ft. from W. Line

NW NW NW

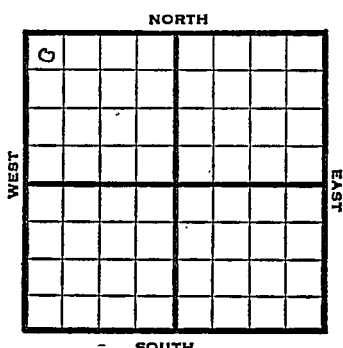

1952	Elev. 1769'	REPORT
2/6	Spud 2-1-52 8" @ 215' Anhy 565-93' Drlg. 2175'	
2/13	Heeb 2909' Br Li 3027' Lans. 3046' DST 3127-35, 1/2 hr, 120 gal, 30' SO & GCM TD 3218' 5" @ 3217' WOC	
2/20	5" @ 3217' WOC	
3/5	NR	
3/11	P/ 30 bopd	
3/19	NR	
3/26	Spud 2-1-52 Oil Well TD 3238 8" @ 215' Anhy 565-93 Heeb. 2909 Br Li 3027 Lans. 3046 DST 3127-35 open 1/2 hr. rec. 120' gas 30' SO&GCM DST 3176-90 open 1/2 hr. rec. 480' oil TD 3218 5" @ 3217 DD 3238 PB 3200 32/ 3182-90 FU 500' oil 2 hr. Comp. 177 bopd	

COMPLETED

County Barton State KansasSec. 11 (Blk.
Twp.) 19 (Sur.
Rge.) 11W Map No.Operator Mastin & HydeWell No. 2 Farm KlepperElev. 1769 Location NW NW NW

0							

330 Ft. From N Line NW330 Ft. From W Line Quarter1st. Report FEB 6 1952

Completion

Remarks

Isern - Contr.Spudding Date 2-1-52Drlg. Data Klepper8" @ 215 Anhy 565-93 Drlg. 2175

J. G. McGEHEE

County Barton State Kansas
 Sec. 11 (Blk. Twp.) 19 (Sur. Rge.) 11W Map No. _____
 Operator Mastin & Hyde
 Well No. 2 Farm Klepper
 Elev. 1769 Location NW NW NW

0					

330 Ft. From N Line NW
 330 Ft. From W Line Quarter
 Ist. Report _____
 Completion MAR 26 1952
 Remarks Klepper Pool
Isern - Contr.
 Spudding Date 2-1-52

Drlg. Data Oil well TD 3238
8" @ 215 Anhy 565-93 Heeb. 2909
Br. lime 3027 Lans. 3046 DST 3127-35
open $\frac{1}{2}$ hr. Rec. 120' gas 30' so & gcm
DST 3176-90 open $\frac{1}{2}$ hr. Rec. 480' oil
TD 3218 5" @ 3217 DD 3238 PB 3200
32/ 3182-90 FU 500' oil 2 hr.
Comp. 177 bopd