


Section 11 Township 19 Range 11W

Well No. #3 Klepper (A)

Company Mastin & Hyde

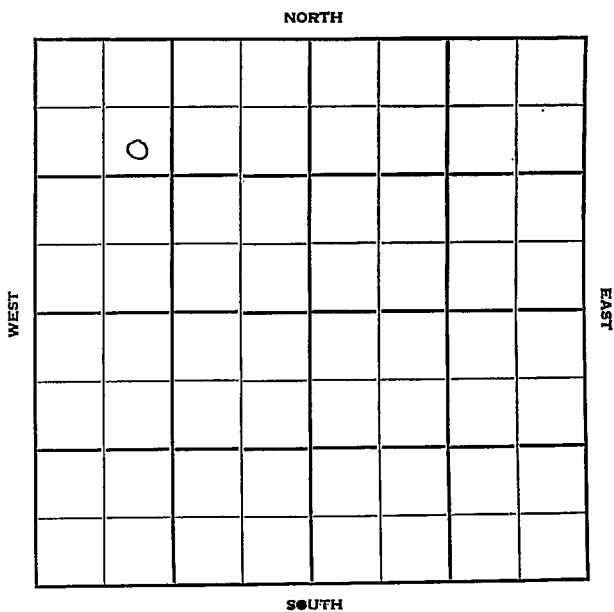

Barton

KANSAS

Sec. 11 Twp. 19 R. 11W

Well No. #3 Klepper (A) Farm

Mastin & Hyde Company

Klepper Contractor


990 Ft. from N. Line

_____ Ft. from S. Line

_____ Ft. from E. Line

990 Ft. from W. Line

SE NW NW

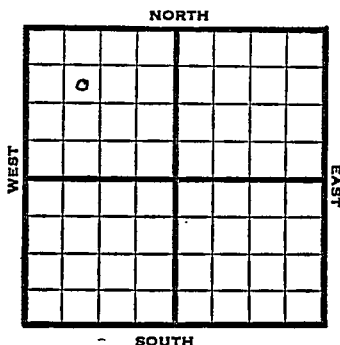

1952 Elev. 1771' REPORT

2/27 Heeb. 2912 Br Li 3030 KC 3050
DST 3131-41 40 mins. 60' muddy wtr.
DST 3181-92, 1/2 hr. 2000' gas 60'
HO&GCM
DST 3218-30 open 45 min. rec. 30'
VSOCM
Cong. 3347-85 TD
5" @ 3270' WOCT

3/5 8" @ 370' WOCT

3/11 20/ 3217-25 1000 A PB 3198
Perf 3181-91 1000 A S/ 10 boph

3/19 NR

3/26 Oil Well TD 3385
Heeb. 2912 Br Li 3030 KC 3050
DST 3131-41 open 40 min. rec. 60'
muddy wtr
DST 3181-92 open 1/2 hr. rec. 2000' gas
60' HO&GCM
DST 3218-30 open 45 min. rec. 30'
VSOCM Cong. 3347
TD 3385 5" @ 3270 20/ 3217-25
1000 A PB 3198 Perf 3181-91
1000 A S/ 10 boph
Comp. 141 bopd 2% wtr.

COMPLETED

County Barton State Kansas

Sec. 11 (Blk.) 19 (Sur.) 11W Map No. (Twp.) (Rge.)

Operator Mastin & Hyde

Well No. 3 Farm Klepper (A)

Elev. 1771 Location SE NW NW

FIRST REPORT

990 Ft. From N Line NW

990 Ft. From W Line Quarter

1st. Report FEB 27 1952

Completion _____

Remarks _____

Spudding Date _____

Drlg. Data Klepper

Heeb 2912 BrL 3030 KC 3050 DST 3131-41

40 Mins. 60' muddy wtr. DST 3181-92 1/2 hr.

2000' gas 60' HO & Gem. DST 3218-30

open 45 min. Rec. 30' vsocm

Cong. 3347-85 TD 5" @ 3270 WOCT

J. G. McGEHEE

