

Section ~~11~~ 11 Township 19 Range 11W

Well No. #4 Klepper (A)

Company Mastin & Hyde

NORTH

	0						

WEST

EAST

SOUTH


Sec. **X 11** Twp. **19** R. **11W** ✓Well No. **#4 Klepper (A)** Farm**Mastin & Hyde** Company**Klepper** Contractor**330** Ft. from N. Line

Ft. from S. Line

Ft. from E. Line

990 Ft. from W. Line

NE NW NW

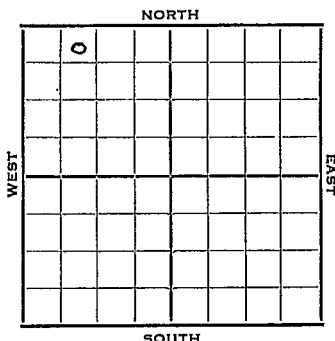

1952

Elev. 1775' REPORT

- 3/5 Spud 2-28-52
Drlg. 2835'
- 3/11 Heeb. 2915 Br Li 3031
Lans. 3049
DST 3132-44 1 hr 45' wtr
DST 3190-3200 1 hr. 30' gas 30' m
SSO TD 3228 5" @ 3225 DO to
3230 NS 250 A
- 3/19 Spud 2-28-52
D&A TD 3230
Heeb. 2915 Br Lime 3031
Lans. 3049
DST 3132-44 opn 1 hr. Rec. 45' wtr.
DST 3190-3200 opn 1 hr. Rec. 30' gas
30' mud TD 3228 5" @ 3225
DD 3230 250 A SP 3206
36/3194-3203 D&A

ABANDONED

County Barton State Kansas
 Sec. 4 (Blk.) 19 (Sur.) 11W Map No.
 (Twp.)
 Operator Mastin & Hyde
 Well No. 4 Farm Klepper (A)
 Elev. Location NE NW NW

0							

FIRST REPORT

330 Ft. From N Line NW
990 Ft. From W Line Quarter
 1st. Report MAR 5 1952

Completion

Remarks

Isern - Contr.

Spudding Date 2-28-52

Drlg. Data

Klepper

Drlg. 2835

J. G. McGEHEE



Operator Mastin & Hyde

Well No. 4 Farm Klepper "A"

Elev.	1775	Location	NE NW NW
-------	------	----------	----------

ABANDONED

330 Ft. From N Line NW

990 Ft. From W Line Quarter

1st. Report

Completion MAR 19 1952

Remarks Klepper Pool

Isern - Contr.

Spudding Date 2-28-52

Drig. Data D & A TD 3230

Heeb. 2915 Br. lime 3031 Lans. 3049

DST 3132-44 open 1 hr. Rec. 45' water

DST 3190-3200 open 1 hr. Rec. 30' gas

30' mud TD 3228 5" @ 3225 DD 3230

250 A SP 3206 36/ 3194-3203

D & A

J. G. McGEHEE

KANSAS

Map No. _____ Sec. 11 Twp. 19 R. 11W

Well No. 4 Klepper "A"

Mastin & Hyde Company

~~CORRECTION~~

Contractor

NE NW NW

SECTION PLAT

330 Ft. from N. Line

_____ Ft. from S. Line

_____ Ft. from E. Line

990 Ft. from W. Line

0			

Barton County

Location _____

Rig up _____

Drilling and Remarks:

Reported

4-19-11W

RECORD

Cased _____ in., _____ ft.

Sand _____

Gas _____

Oil _____

Total Depth _____

PRODUCTION

1st 24 hrs. Nat. _____

1st 24 hrs. after shot _____

Gas _____ Cu. Ft.

Dry Hole _____

Abandoned _____

Date

MAR 12 1952 19

J. G. McGEHEE

Scout