


Section 11 Township 19 Range 11-W

Well Number #1-Rader

Company Shell

NORTH *SPECIAL*

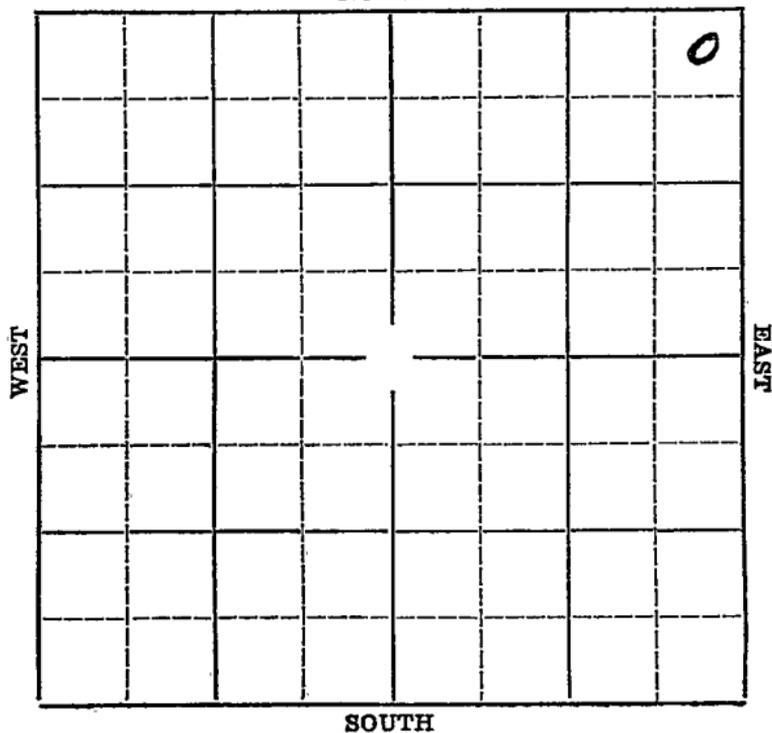

Sec. 11 Twp. 19 R. 11W

Well No. #1 Rader Farm  
Shell Company


330 Ft. from N. Line

\_\_\_\_\_ Ft. from S. Line

330 Ft. from E. Line

\_\_\_\_\_ Ft. from W. Line

Elevation 1770

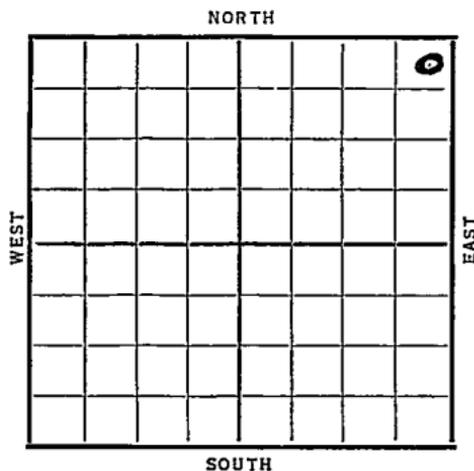

Date 1936

**SPECIAL** REPORT

8/26	Rig on ground.
9/3	Rigging up.
9/10	12" @ 250'. Drlg. 2228'.
9/18	Kansas City 3028'. Drlg. 3204'.
9/24	Drlg. 3285'.
10/1	Siliceous 3327'. T.D. 3332'. 7"@ 3324'. Bailing mud.
10/8	T.D. 3374½'. 2/3 bailer of oil and some water.
10/15	1000 gallons of acid. Pump 260 oil and 40 water. 3000 gallons of acid. No test.
10/21	36-Sil. 3327'. T.D. 3374½'. 4000 gallons of acid. Potential 358 oil and 240 wat.

**COMPLETED**

Map No. 46 Sec. 11 Twp. 19 R. 11W

Well No. 1 Rader.

Sho 16 Company

Contractor

SPECIAL

SECTION PLAT

			0

330 Ft. from N. Line

\_\_\_\_\_ Ft. from S. Line

330 Ft. from E. Line

\_\_\_\_\_ Ft. from W. Line

FIRST REPORT

Location \_\_\_\_\_

Rig up \_\_\_\_\_

Drilling and Remarks:

ROG

RECORD

Cased \_\_\_\_\_ in., \_\_\_\_\_ ft.

Sand \_\_\_\_\_

Gas \_\_\_\_\_

Oil \_\_\_\_\_

Total Depth \_\_\_\_\_

PRODUCTION

1st 24-hrs. Nat. \_\_\_\_\_

1st 24 hrs. after shot \_\_\_\_\_

Gas \_\_\_\_\_ Cu. Ft.

Dry Hole \_\_\_\_\_

Abandoned \_\_\_\_\_

Date

AUG 26 1936 19

S. J. LEWIS Scout

# KANSAS

Form 26 - 1M Eks. - 2-29

Map No. 46 Sec. 11 Twp. 19 R. 11W

Well No. 1 Rader

Shell Company

Contractor

## SECTION PLAT

			○

330 Ft. from N. Line

\_\_\_\_\_ Ft. from S. Line

330 Ft. from E. Line

\_\_\_\_\_ Ft. from W. Line

**COMPLETED**

Location \_\_\_\_\_

Rig up \_\_\_\_\_

Drilling and Remarks:

*Sil 2327*  
*4000 acid*  
*Potential*  
*358 oil*  
*240 water*

## RECORD

Cased \_\_\_\_\_ in., \_\_\_\_\_ ft.

Sand \_\_\_\_\_

Gas \_\_\_\_\_

Oil \_\_\_\_\_

Total Depth 3374 1/2

## PRODUCTION

1st 24 hrs. Nat. \_\_\_\_\_

1st 24 hrs. after shot \_\_\_\_\_

Gas \_\_\_\_\_ Cu. Ft.

Dry Hole \_\_\_\_\_

Abandoned \_\_\_\_\_

Date

OCT 21 1936<sub>19</sub>

S. J. LEWIS Scout