

KANSAS


Barton

FORM 51 5M 4-41 PETROL

Section 11 Township 19 Range 11W

Well No. #2 Rader

Company Shell

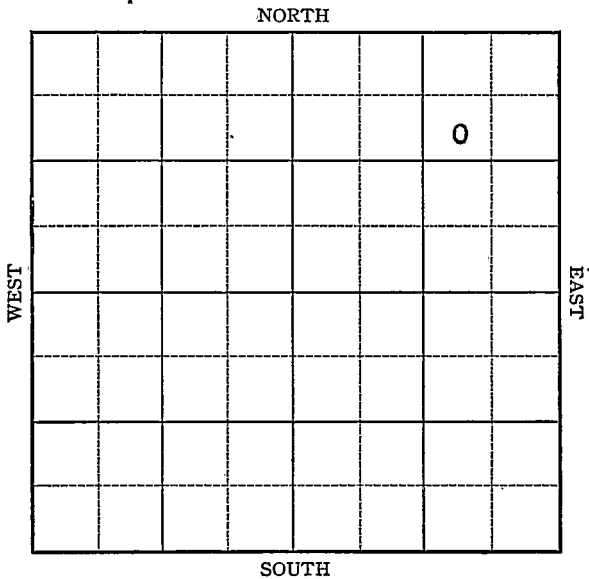

Sec. 11 Twp. 19 R. 11-W

Well No. #2 Rader Farm

Shell Company

(Rick)


990 Ft. from N. Line

_____ Ft. from S. Line

990 Ft. from E. Line

_____ Ft. from W. Line

Elev. 1764

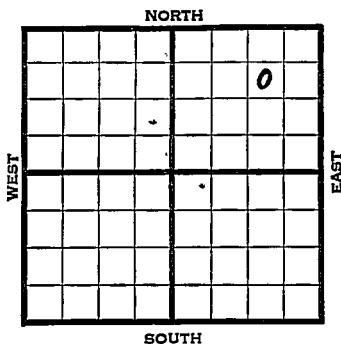

1941	REPORT
9/3	Cellar.
9/11	8" - 346' Drlg. 2302'
9/18	Topeka 2639' Lans. 3026'
	Simp. sand 3328' Simp. sh. 3331'
	Arb. 3345' T.D. 3347'
9/25	4" - 3345' T.D. 3347'
10/2	T.D. 3263' P.B. to 3147'
	12 shots 3070-73½'
	12 shots 3044-47½' 2 M gas.
10/9	" " " "
10/16	Shut down.
10/23	" "
10/30	" "
11/6	" "
11/13	" "
11/19	" "
11/28	" "
12/4	" "
12/11	" "


1941

12/18


12/23

Arb. 3345'

4" - 3345'

Lans. 3026'

T.D. 3347'

P.B. to 3147'

12 shots 3070-73 $\frac{1}{2}$ '

12 " 3044-47 $\frac{1}{2}$ '

1,836,000 cu. ft. gas.

COMPLETED

Map No. _____ Sec. 11 Twp. 19 R. 11WWell No. 2 RaderShell

Company _____

FIRST REPORT

Contractor _____

SW NE NE

990 Ft. from N. Line

_____ Ft. from S. Line

990 Ft. from E. Line

_____ Ft. from W. Line

RICK POOL

SECTION PLAT

			o

Location _____

Rig up _____

Drilling and Remarks:

Cellar

RECORD

Cased _____ in., _____ ft.

Sand _____

Gas _____

Oil _____

Total Depth _____

PRODUCTION

1st 24 hrs. Nat. _____

1st 24 hrs. after shot _____

Gas _____ Cu. Ft.

Dry Hole _____

Abandoned _____

Date

SEP 3 1941 19

S. J. LEWIS Scout

Misc. Small Maps
Cards
Tracing
France Map
Scarborough Map
Moody Map
Geological Dept.
Moody Flat Book

RAY
Ray
J. W. Ray
J. W. Ray

Map No. 46 Sec. 11 Twp. 19 R. 11WWell No. 2 RaderShell

Company

Contractor

COMPLETED

SW NE NE

SECTION PLAT

990 Ft. from N. Line Ft. from S. Line990 Ft. from E. Line Ft. from W. Line

			o

RICK P OOL

RECORD

Location _____

Cased _____ in., _____ ft.

Rig up _____

Sand _____

Drilling and Remarks:

Gas _____

Oil _____

Total Depth 3342

PRODUCTION

1st 24 hrs. Nat. _____

1st 24 hrs. after shot _____

Gas _____ Cu. Ft.

Dry Hole _____

Abandoned _____

CEL #33454" @ 3345Lane 3026P.B. 814712 sh to 3070-73 1/212 " 3044-47 1/21,986,000 cu ft.gas

Date

DEC 23 1941

19

S. J. LEWIS Scout

Misc Small Maps	<i>[Handwritten mark]</i>
Cards	<i>[Handwritten mark]</i>
Tracing	<i>[Handwritten mark]</i>
France Map	<i>[Handwritten mark]</i>
Scarborough Map	<i>[Handwritten mark]</i>
Moody Map	<i>[Handwritten mark]</i>
Geological Dept.	
Moody Flat Book	