

KANSAS


Barton

Section 11 Township 19 Range 11-W

Well No. #2 Opal Lanterman

Company E H Adair

NORTH

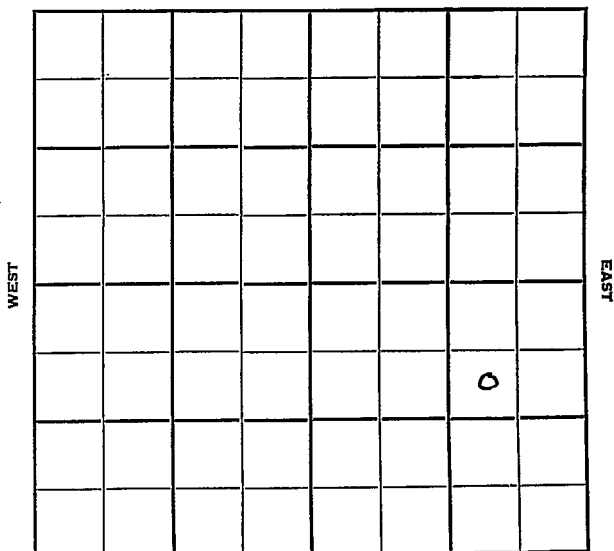

SOUTH

Barton

KANSAS
11W

Sec. 11 Twp. 19 R. ✓

Well No. #2 Opal Lanterman Farm

E. H. Adair Company

Adair- Contr. Contractor

Rick Pool


990' Ft. from N. Line

Ft. from S. Line

990' Ft. from E. Line

Ft. from W. Line

SW NE SE

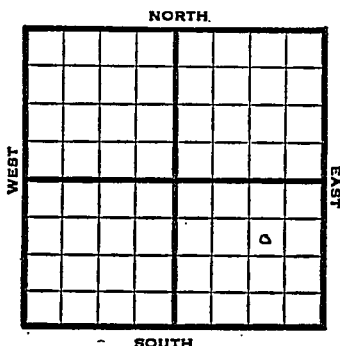

1950

Elev 1770'

REPORT

11/8

Spud 11-7-50

Drlg. 476'

12/20

8" @ 223

Anhy 532

Top 2642

Heeb 2898

Br lime 3018

Lans 3035

Arb. 3318-20

5" @ 3319

TD 3336

FU 900' fluid 16 hr

500 A S/3 1/3 boph 500' oil 17 hr

2000 A S/4 boph

Comp 30 bopd


Completed

COMPLETED

Scout Cards	
Land Small Map	
Land Wall Map	
Tracing	
France Map	
Pierce Map	
Misc.	

NOV 1 0 1954

County Barton State Kansas
 Sec. 11 (Blk. 19 (Sur. 11W Map No.
 (Twp.) (Rge.)
 Operator E. H. Adair
 Well No. 2 Farm Opal Lanterman
 Elev. 1770 Location SW NE SE

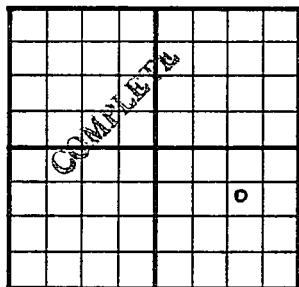

990 Ft. From N Line SE
990 Ft. From E Line Quarter
 1st. Report
 Completion DEC 20 1950
 Remarks Rick Pool
Adair - Contr.
 Spudding Date 11-7-50

Drlg. Data Oil well TD 3336
8" C 223 Anhy 532 Top. 2642
Heeb. 2898 Br. lime 3018 Lans. 3035
Arh. 3318-20 5" C 3319 TD 3336
FU 900' fluid 16 hr. 500 A S/ 3 1/3 boph
500' oil 17 hr. 2000 A S/ 4 boph
Comp. 30 bopd

DEC 27 1950

Scout Cards	F.W.
Land Stream Map	
Land Wall Map	5
Tracings	
France M p	
Pierce Map	
Misc.	

Drig. Data