


KANSAS

Rice

Section 11 Township 19 Range 10W

Well No. #1 Brandenstein
~~Springer Est~~

Company Herndon Drlg

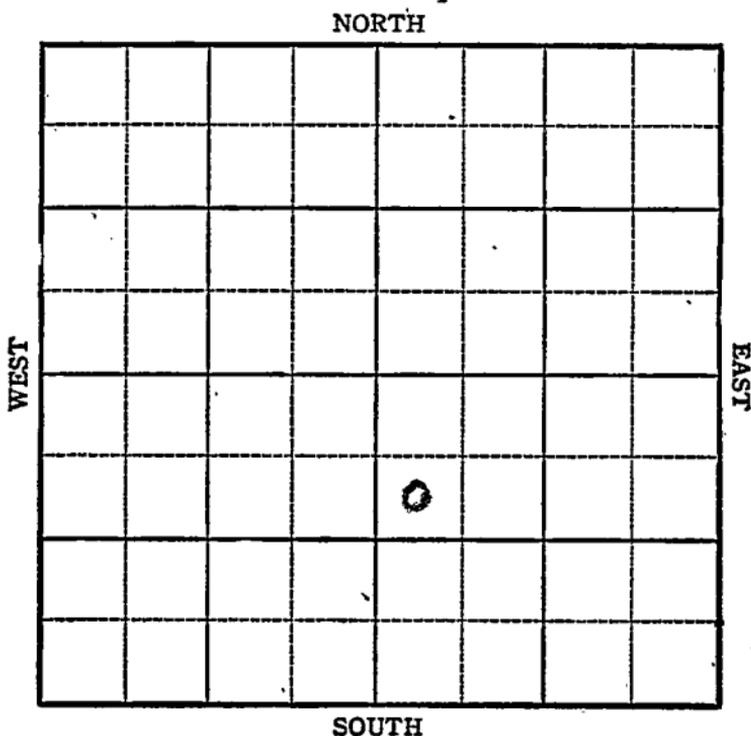

Sec. KANSAS Twp. Rice 19 R. LOW
Well No. #1 Brandenstein Farm
Springer Est.
Herndon Drlg. Company

Chase


990 Ft. from N. Line

Ft. from S. Line

Ft. from E. Line

330 Ft. from W. Line

Elev. 1743

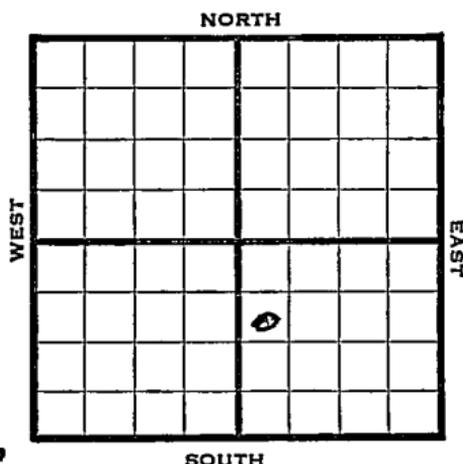

REPORT

1944

- 7/26 Derrick
- 8/2 8" @ 210 Drlg. 1800
- 8/9 Lans 2934 SD 2958 Drlg. 3015
- 8/16 Cong 3260
Arb. 3299
TD 3301 S
- 8/23 42 shots 3008-16
1500 acid swb 60 oil plus 60 Wtr in 24 hrs.
- 8/30 500 acid No help to perf.
- 9/8 51 shots 3108-28
1500 acid swb 4 oil per hr.
- 9/13 Packer 3058 6500 acid Pump 14 oil P.
- 9/21 " " " " " " "
- 9/28 Squeeze Perf. 3008-16 WOC
- 10/4 Arb 3299
5" @ 3301
Lans 2934
Perf. Lans.
5500 acid
Pump 72 oil plus 72 wtr pot.
TD 3301
Grav. 40.7

COMPLETED

Pool Name Chase

KANSAS

Map No. 46 Sec. 11 Twp. 19 R. 10WWell No. 1 Springer Est.Herndon Drlg. Company

FIRST REPORT Contractor


SW NW SE

SECTION PLAT

990 Ft. from N. Line

_____ Ft. from S. Line

_____ Ft. from E. Line

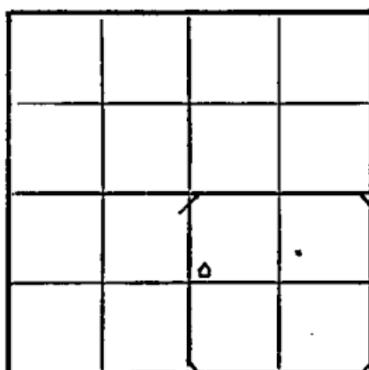330 Ft. from W. Line

Rice County

RECORD

Location _____

Cased _____ in., _____ ft.

Rig up _____

Sand _____

Drilling and Remarks:

Gas _____

Derrick

Oil _____

Total Depth _____

PRODUCTION

1st 24 hrs. Nat. _____

1st 24 hrs. after shot _____

Gas _____ Cu. Ft.

Dry Hole _____

Abandoned _____

Date

JUL 26 1944

19

S. J. LEWIS Scout/

Pool Name Chase

Map No. 46 Sec. 11 Twp. 19 R. 10W

Well No. 1 Brandenstein

Herndon Drlg. Company

CORRECTION Contractor

SW NW SE


SECTION PLAT

990 Ft. from N. Line

_____ Ft. from S. Line

_____ Ft. from E. Line

330 Ft. from W. Line

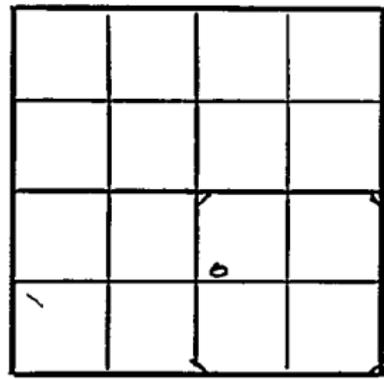

Rice County

Location _____

Rig up _____

Drilling and Remarks:

Reported
#1 Springer Est.

RECORD

Cased _____ in., _____ ft.

Sand _____

Gas _____

Oil _____

Total Depth _____

PRODUCTION

1st 24 hrs. Nat. _____

1st 24 hrs. after shot _____

Gas _____ Cu. Ft.

Dry Hole _____

Abandoned _____

Date

AUG 23 1944 19

S. J. LEWIS Scout

Pool Name Chase PoolMap No. 46 Sec. 11 Twp. 19 R. 10WWell No. 1 BrandenstienHerndon Drlg. CompanyCOMPLETED Contractor

SW NW SE

SECTION PLAT

990 Ft. from N. Line

_____ Ft. from S. Line

330 Ft. from E. Line

_____ Ft. from W. Line

Rice County

Location _____

Rig up _____

Drilling and Remarks:

Art 3299
5" @ 3301
have 2984
Pay down.
3500 acid
Pump 72 oil + 72 water
St. 4026

RECORD

Cased _____ in., _____ ft.

Sand _____

Gas _____

Oil _____

Total Depth 3301

PRODUCTION

1st 24 hrs. Nat. _____

1st 24 hrs. after shot _____

Gas _____ Cu. Ft.

Dry Hole _____

Abandoned _____

Date

OCT 4 1944 19S. T. LEWIS Scout