


Section 11 Township 19 Range 10W

Well No. #12 Brandenstein

Company M. Wunderlich

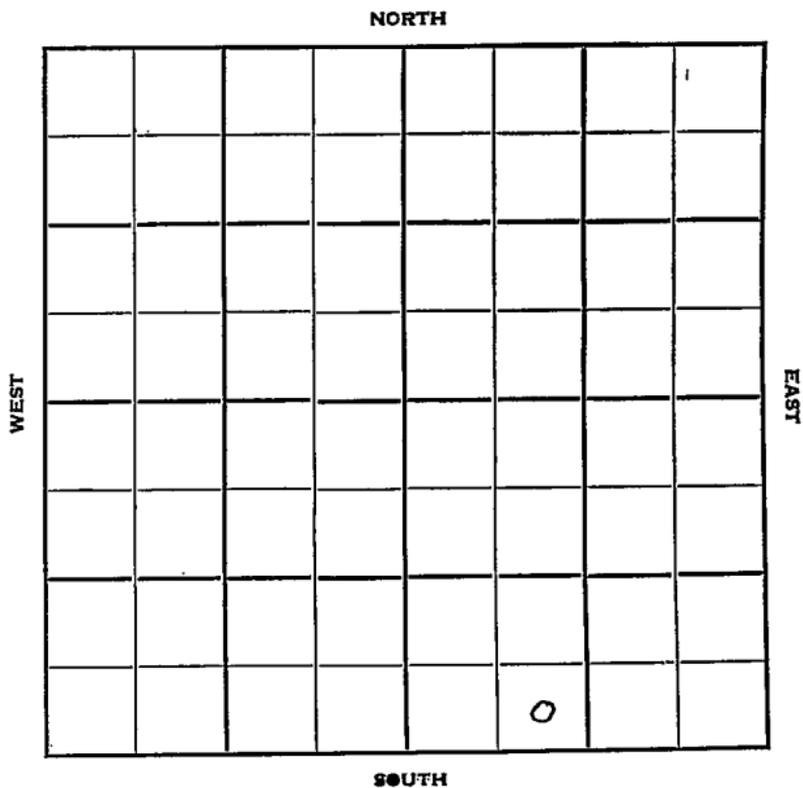

Rice

KANSAS

Sec. 11 Twp. 19 R. 10 W

Well No. # 12 Brandenstein Farm

M. Wunderlich Company

Mallonee Drlg. Contractor

Chose-Silicia


 Ft. from N. Line

330 Ft. from S. Line

~~990~~ Ft. from E. Line

990 Ft. from W. Line

~~SW SE SE~~
SE SW SE

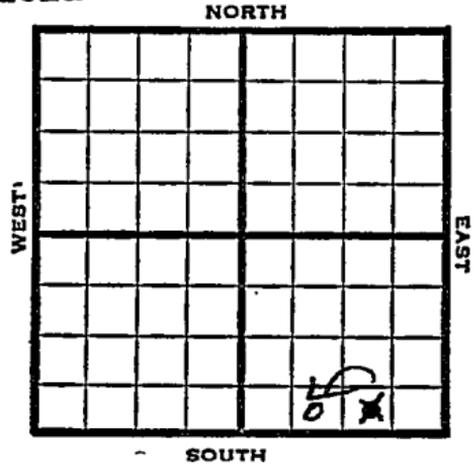

1952

Elev. 1740' REPORT

1/9

Spud 1-1-52

8" @ 250'

Drlg. 2100'

1/30

Spud 1-1-52

D&A TD 3288

8" @ 250

Heeb. 2798 Br lime 2923

Lans. 2947 SO 3002-16,

3029-53, 3129-41

Cong. 3275 Arb. 3281-85

5" @ 3281 TD 3288 300 A

wtr & SSO D&A

ABANDONED

21

Scout Cards	MM
Land Gravel Map	
Land Wall Map	3
Tracings	
France Map	
Pierce Map	
Misc.	

JAN 1 1 1952

Orig. Data

Map No. _____ Sec. 11 Twp. 19 R. LOW

Well No. 12 Brandenstein

Martin Wunderlich Company

CORRECTION Contractor

SE SW SE


SECTION PLAT

_____ Ft. from N. Line

330 Ft. from S. Line

_____ Ft. from E. Line

990 Ft. from W. Line

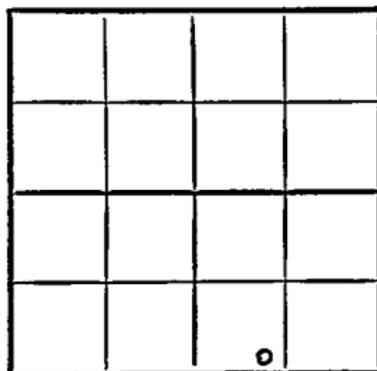

Rice County

Location _____

Rig up _____

Drilling and Remarks:

Reported

SW SE SE

RECORD

Cased _____ in., _____ ft.

Sand _____

Gas _____

Oil _____

Total Depth _____

PRODUCTION

1st 24 hrs. Nat. _____

1st 24 hrs. after shot _____

Gas _____ Cu. Ft.

Dry Hole _____

Abandoned _____

Date

JAN 9 1952

19

J. E. TYRA

Scout

Faint, mostly illegible text and markings scattered across the upper and middle portions of the page.

ORC

- Scout Cards *mm*
- Land Small Map
- Land Wall Map *5*
- Tracings
- France Map
- Pierce Map
- Misc.

JAN 15 1952

FEB 6

- Scout Cards _____
- Land Small Map _____
- Land Wall Map _____
- Tracings _____
- France Map _____
- France Map _____
- Misc _____

Orig. Data