


Section 11 Township 19 Range 10WWell No. #10 BrandensteinCompany Martin Wunderlich

NORTH

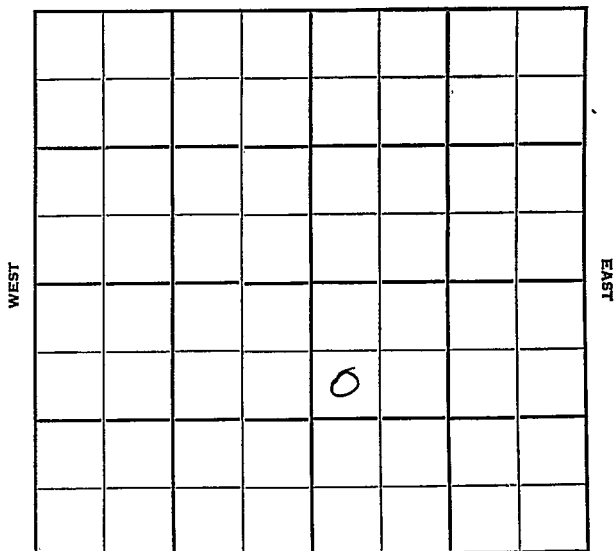

SOUTH

Rice


KANSAS

Sec. 11 Twp. 19 R. 10WWell No. #10 Brandenstein FarmMartin Wunderlich CompanyTodd Drlg. Contractor

Chase Pool

990 Ft. from N. Line Ft. from S. Line Ft. from E. Line330 Ft. from W. Line

SW NW SE

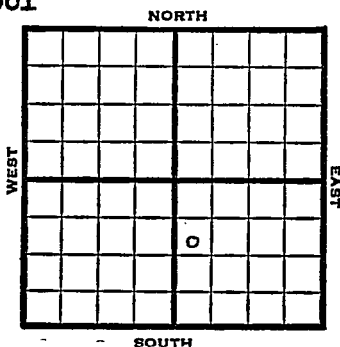

1952

Elev. 1743' REPORT

1/2

Spud 12-22-51

8" @ 250'

Drlg. 2526'

2/6

TD 3291'

5" @ 3270' POP

2/13

No report

2/20

Spud 12-22-51

Oil well TD 3292' 8" @ 250'

Heeb 2787' Br. lime 2910'

Lans. 2936' Cong. 3250' Ch.

Cong. 3262' TD 3292' 5" @ 3270'


GO to 3270' 24/3018-41 500 A

S/4 $\frac{1}{2}$ BOPH 1 $\frac{1}{2}$ BWPH 2 hr.

Comp. 50 BOPD

COMPLETED


County Rice State Kansas
 Sec. 11 (Blk. Twp.) 19 (Sur. Rge.) 10W Map No.
 Operator Martin Wunderlich
 Well No. 10 Farm Brandenstein
 Elev. _____ Location SW NW SE

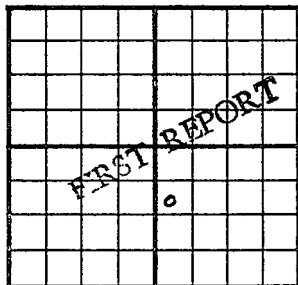

990 Ft. From N Line SE
330 Ft. From W Line _____ Quarter _____
 1st. Report JAN 2 1952
 Completion _____
 Remarks _____
Todd Drlg. - Contr.
 Spudding Date 12-22-51

Drlg. Data Chase Pool
8" @ 250 drlg. 2526

County Rice State Kansas
 Sec. 11 (Blk.) 19 (Sur.) 10W Map No.
 Operator Martin Wunderlich
 Well No. 10 Farm Brandenstein
 Elev. 1743 Location SW NW SE

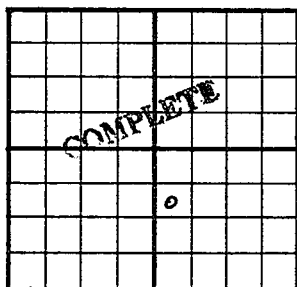

990 Ft. From N Line SE
330 Ft. From W Line Quarter
 1st. Report
 Completion FEB 20 1952
 Remarks Chase Pool
Todd Drig.-- Contr.
 Spudding Date 12-22-51

Drig. Data Oil well TD 3292

8" @ 250 Heeb. 2787 Br. lime 2910

Lans. 2936 Cong. 3250 Ch. Cong. 3262

TD 3292 5" @ 3270 CO to 3270

24/ 3018-41 500 A S/ 4½ boph

1½ bwph 2 hr. Comp. 50 bopd

J. G. McGEHEE