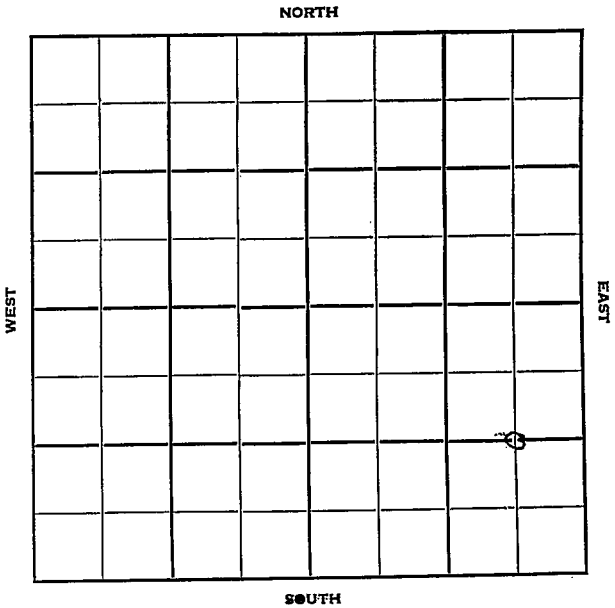


Section 11 Township 19 Range 10WWell No. W#9 BrandensteinCompany Martin Wunderlich

Rice

KANSAS

Sec. 11 Twp. 19 R. 10 W

Well No. # 9 Brandenstein Farm

Martin Wunderlich Company

Edwards Drlg. Contractor

Chase Pool

1320
990 Ft. from N. Line


 Ft. from S. Line

990 Ft. from E. Line

 Ft. from W. Line

C W L E / 2 S E

SW NE SE

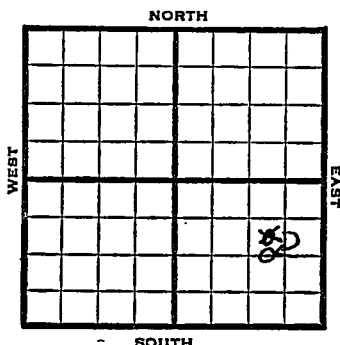

1952

Elev. 1737' REPORT

1/9

Spud 12-23-51
8" @ 250'
Drlg. 2720'

1/30

Spud 12-23-51
Oil Well TD 3283
8" @ 250
Heeb. 2782 Br line 2904
Lans. 2929 SO 3014-36 3120-30
3140-47 Cong. 3258
Arb. 3266
TD 3270 5" @ 3267 DD 3283
200 A HFO Comp. 60 bopd

COMPLETED

County Rice State KansasSec. 11 (Blk. Twp.) 19 (Sur. Rge.) 10W Map No.Operator Martin WunderlichWell No. 9 Farm BrandensteinElev. Location SW NE SE

FIRST REPORT

990 Ft. From N Line SE990 Ft. From E Line Quarter1st. Report JAN 9 1952

Completion

Remarks

See correction
Edwards Drlg. - Contr.Spudding Date 12-23-51Drlg. Data Chase Pool8" @ 250 drlg. 2720

Map No. 11 Sec. 11 Twp. 19 R. 10W

Well No. 9 Brandenstein

Martin Wunderlich Company

CONFECTION

Contractor

C W L E $\frac{1}{2}$ SE

SECTION PLAT

1320 Ft. from N. Line

 Ft. from S. Line

990 Ft. from E. Line

 Ft. from W. Line

Rice County

Location

Rig up

Drilling and Remarks:

Reported

SW NE SE'

RECORD

Cased in., ft.

Sand

Gas

Oil

Total Depth

PRODUCTION

1st 24 hrs. Nat.

1st 24 hrs. after shot

Gas Cu. Ft.

Dry Hole

Abandoned

Date

JAN 9 1952 19


J. E. TYRA Scout

County Rice State Kansas
 Sec. 11 (Blk.) 19 (Sur.) 10W Map No.

Operator Martin Wunderlich

Well No. 9 Farm Brandenstein

Elev. 1737 Location C W L E $\frac{1}{2}$ SE

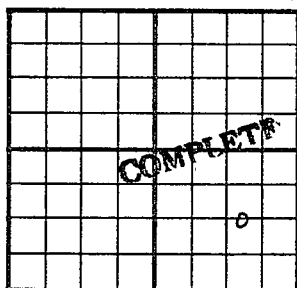

1320 Ft. From N Line SE

990 Ft. From E Line Quarter

1st. Report

Completion JAN 30 1952

Remarks Chase Pool

Edwards Drlg. - Contr.

Spudding Date 12-23-51

Drlg. Data Oil well TD 3283

8" @ 250 Heeb. 2782 Br. lime 2904

Lans. 2929 SO 3014-36 3120-30

3140-47 Cong. 3258 Arb. 3266

TD 3270 5" @ 3267 DD 3283 200 A

HFO Comp. 60 bopd

J. G. McGEHEE