


Section 11 Township 19 Range 10 W

Well No. # 6 Brandenstein

Company Martin Wunderlick

NORTH

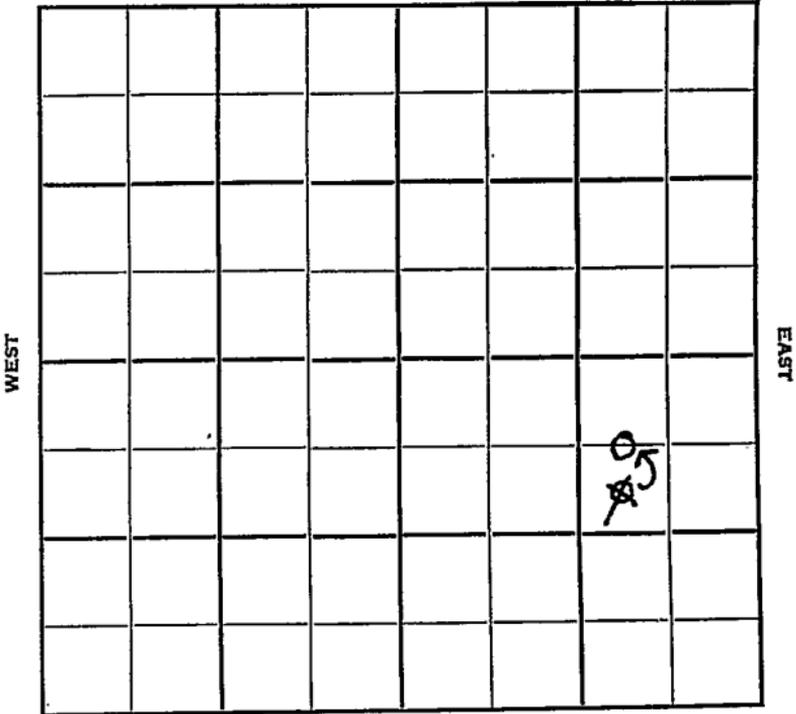

SOUTH

Rice

KANSAS
R. 10 W

Sec. 11 Twp. 19

Well No. # 6 Brandenstein Farm

Martin Wunderlick Company

Pickerell Drlg. Contractor

Silica - Chase Pool

660
~~990~~ Ft. from N. Line


Ft. from S. Line

990 Ft. from E. Line

Ft. from W. Line

CWL NE SE

~~SW NE SE~~

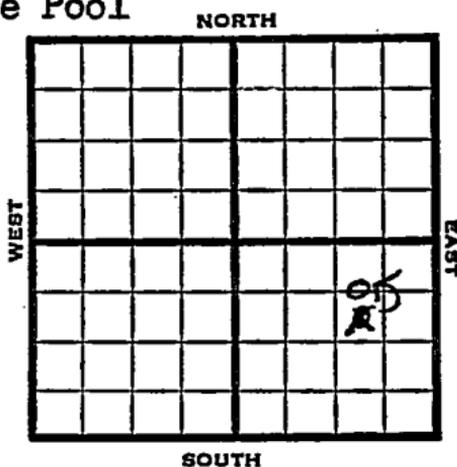

1951

Elev. 1734' REPORT

12/12

Spud 12-11-51
8" @ 208
Drlg. 1033'

1952
1/9

Spud 12-11-51
Oil Well TD 3270
8" @ 208
Heeb. 2768 Br Lime 2893
Lans. 2918 Arb. 3250
TD 3255
5" @ 3251 TD 3270 1300 A S/3 bopd
Comp. 50 bopd

COMPLETED

County Rice State Kansas

Sec. 11 (Blk. Twp.) 19 (Sur. Rge.) 10W Map No.

Operator Martin Wunderlick

Well No. 6 Farm Brandenstein

Elev. Location SW NE SE

FIRST REPORT

990 Ft. From N Line SE

990 Ft. From E Line Quarter

Ist. Report DEC 1 2 1951

Completion

Remarks Pickrell Drlg. - Contr.

Spudding Date 12-11-51

Drlg. Data Silica - Chase Pool

8" @ 208 drlg. 1033

J. E. TYRA

Kansas

Map No. _____ Sec. 11 Twp. 19 R. 10W

Well No. 6 Brandenstein

Martin Wunderlich Company

CORRECTION

Contractor

C W L NE SE

SECTION PLAT

660 Ft. from N. Line

_____ Ft. from S. Line

990 Ft. from E. Line

_____ Ft. from W. Line

			o

Rice County

Location _____

Rig up _____

Drilling and Remarks:

Reported

SW NE SE

RECORD

Cased _____ in., _____ ft.

Sand _____

Gas _____

Oil _____

Total Depth _____

PRODUCTION

1st 24 hrs. Nat. _____

1st 24 hrs. after shot _____

Gas _____ Cu. Ft.

Dry Hole _____

Abandoned _____

Date

DEC 1 9 1951

J. E. TYRA

Scout

County Rice State Kansas

Sec. 11 (Blk.) 19 (Sur.) 10W Map No.

Operator Martin Wunderlich

Well No. 6 Farm Brandenstein

Elev. 1734 Location C W L NE SE

COMPLETE

660 Ft. From N Line SE

990 Ft. From E Line Quarter

Ist. Report

Completion JAN 9 1952

Remarks Silica - Chase Pool

Pickrell Drlg. - Contr.

Spudding Date 12-11-51

Drlg. Data Oil well TD 3270

8" @ 208 Heeb. 2768 Br. line 2893

Lans. 2918 Arb. 3250 TD 3255

5" @ 3251 TD 3270 1300 A S/ 3 boph

Comp. 50 bopd