

Company Branine & Holl

EAST

**SOUTH**

Rice

KANSAS

Sec. 11 Twp. 19 R. 10W

Well No. #5 Brandenstein Farm

Branine & Holl Company

Brunson Drlg. Contractor

Brandenstein


Ft. from N. Line

330' Ft. from S. Line

330' Ft. from E. Line

Ft. from W. Line

SE NE

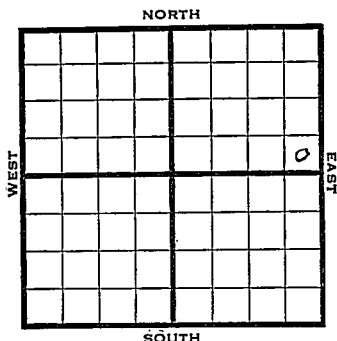

1949 Elev 1727' REPORT

11/2 Surface Hole  
11/9 8" @ 149'  
11/23 Drlg. 2963'  
TD 3282' in Cong.  
Lansing 2904'  
Cong 3244'  
5" @ 3245'  
Perf Lans.  
2000 acid  
Pump 50 Oil Pot  
42° Gr.  
Comp

**COMPLETED**

Kansas

Map No. \_\_\_\_\_ Sec. 11 Twp. 19 R. 10WWell No. 5 BrandensteinBranine & Holl

Company

Brunson Drlg.

Contractor

SE NE

FIRST REPORT  
SECTION PLAT

|  |  |  |   |
|--|--|--|---|
|  |  |  |   |
|  |  |  |   |
|  |  |  | o |
|  |  |  |   |
|  |  |  |   |

       Ft. from N. Line330 Ft. from S. Line330 Ft. from E. Line       Ft. from W. Line

Rice County

Location \_\_\_\_\_

Rig up \_\_\_\_\_

Drilling and Remarks:

surface hole

## RECORD

Cased \_\_\_\_\_ in., \_\_\_\_\_ ft.

Sand \_\_\_\_\_

Gas \_\_\_\_\_

Oil \_\_\_\_\_

Total Depth \_\_\_\_\_

## PRODUCTION

1st 24 hrs. Nat. \_\_\_\_\_

1st 24 hrs. after shot \_\_\_\_\_

Gas \_\_\_\_\_ Cu. Ft.

Dry Hole \_\_\_\_\_

Abandoned \_\_\_\_\_

Date

NOV 2 1949 19

S. J. LEWIS

Scout

Map No. \_\_\_\_\_ Sec. 11 Twp. 19 R. 10W

Well No. 5 Brandenstein

Branine & Holl Company

COMPLETE

Contractor

SE NE


*E11727*  
SECTION PLAT

\_\_\_\_\_ Ft. from N. Line

330 Ft. from S. Line

330 Ft. from E. Line

\_\_\_\_\_ Ft. from W. Line

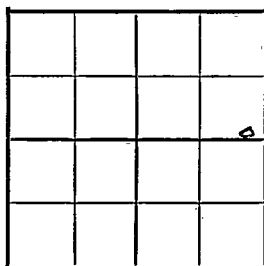

Rice County

Location \_\_\_\_\_

Rig up \_\_\_\_\_

Drilling and Remarks:

*Ham 2504*

*Comp 3244*

*5" @ 3245*

*Perf Ham.*  
*soooacut*

*Run 50 oil 1st*  
*42.2 gal*

RECORD

Cased \_\_\_\_\_ in., \_\_\_\_\_ ft.

Sand \_\_\_\_\_

Gas \_\_\_\_\_

Oil \_\_\_\_\_

Total Depth *3242 in Comp*

PRODUCTION

1st 24 hrs. Nat. \_\_\_\_\_

1st 24 hrs. after shot \_\_\_\_\_

Gas \_\_\_\_\_ Cu. Ft.

Dry Hole \_\_\_\_\_

Abandoned \_\_\_\_\_

Date

NOV 23 1949 19

S. J. LEWIS Scout