

KANSAS


FORM 51 10M 8-47

Rice

Section 11 Township 19 Range 10WWell No. #3 Brandenstern (*Brandenstein*)Company Branine & Holl

Silica

NORTH

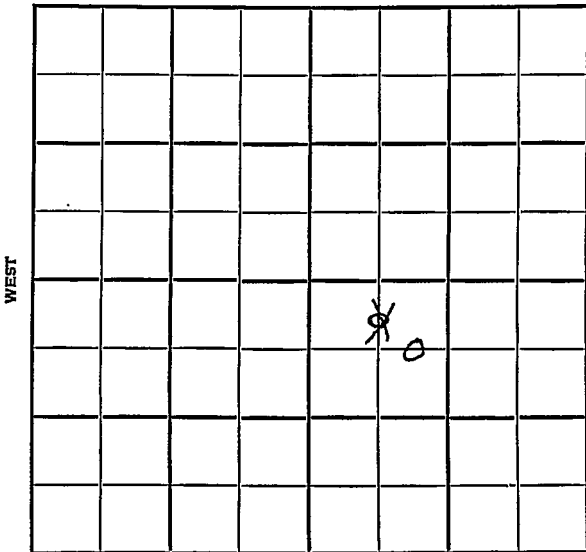

SOUTH

KANSAS

Rice

Sec. 11 Twp. 19 R. 10W

Well No. #3 Brandenstern Farm
Branine & Holl Company
Silica


660'
330 Ft. from N. Line

_____ Ft. from S. Line

_____ Ft. from E. Line

990'
660 Ft. from W. Line

6 Silica
C. N L NW SE

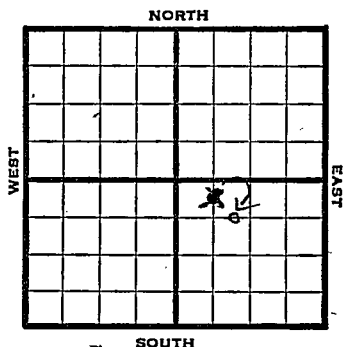

1947

Elev. 1739

R E P O R T

10/22 10" @ 278'
WOC

10/29 Drlg. 2100'

11/5 7" @ 2995'

11/12 Lansing 2922'
7" @ 2995'
TD 3001' HFO

11/25 Lansing 2922
7" @ 2995
Pump 52 Pot
TD 3001
Gravity 42

COMPLETED

Map No. _____ Sec. 11 Twp. 19 R. 10WWell No. 3 BrandensternBranine & Holl CompanyFIRST REPORT Contractor

C N L NW SE

SECTION PLAT

		o	

330 Ft. from N. Line

_____ Ft. from S. Line

_____ Ft. from E. Line

660 Ft. from W. LineRice County

Location _____

Rig up _____

Drilling and Remarks:

10" @ 278' WOC

RECORD

Cased _____ in., _____ ft.

Sand _____

Gas _____

Oil _____

Total Depth _____

PRODUCTION

1st 24 hrs. Nat. _____

1st 24 hrs. after shot _____

Gas _____ Cu. Ft.

Dry Hole _____

Abandoned _____

Date

OCT 22 1947

19

S. J. LEWIS Scout

Map No. 46 Sec. 11 Twp. 19 R. 10W

Well No. 3 Brandenstien

Branine & Goll Company

CORRECTION Contractor

C E L NW SE


SECTION PLAT

660 Ft. from N. Line

 Ft. from S. Line

 Ft. from E. Line

990 Ft. from W. Line

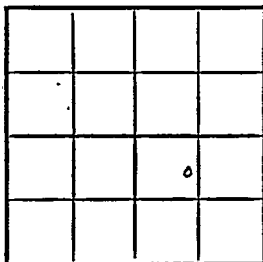

Rice County

Location

Rig up

Drilling and Remarks:

Reported

C N L NW SE

RECORD

Cased in., ft.

Sand

Gas

Oil

Total Depth

PRODUCTION

1st 24 hrs. Nat.

1st 24 hrs. after shot

Gas Cu. Ft.

Dry Hole

Abandoned

Date

NOV 5 1947 19 S. J. LEWIS Scout

Map No. 46 Sec. 11 Twp. 19 R. 10W

Well No. 3 Brandenstein

Branine & Holl Company

COMPLETE

Contractor

C E L N W S E


E 11/289
SECTION PLAT

660 Ft. from N. Line

 Ft. from S. Line

 Ft. from E. Line

990 Ft. from W. Line

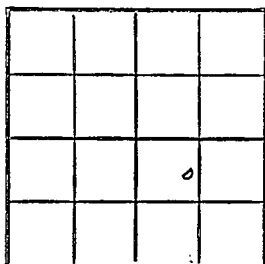

Rice County

Location

Rig up

Drilling and Remarks:

Lones 2922

9' 02995

Pump 52 Pst

72 2/3

RECORD

Cased in. ft.

Sand

Gas

Oil

Total Depth 5201

PRODUCTION

1st 24 hrs. Nat.

1st 24 hrs. after shot

Gas Cu. Ft.

Dry Hole

Abandoned

Date

NOV 25 1947 19

S. J. LEWIS

Scout