


Section 11 Township 19 Range 10W

Well No. #11 Brandenstein

Company Martin Wunderlich

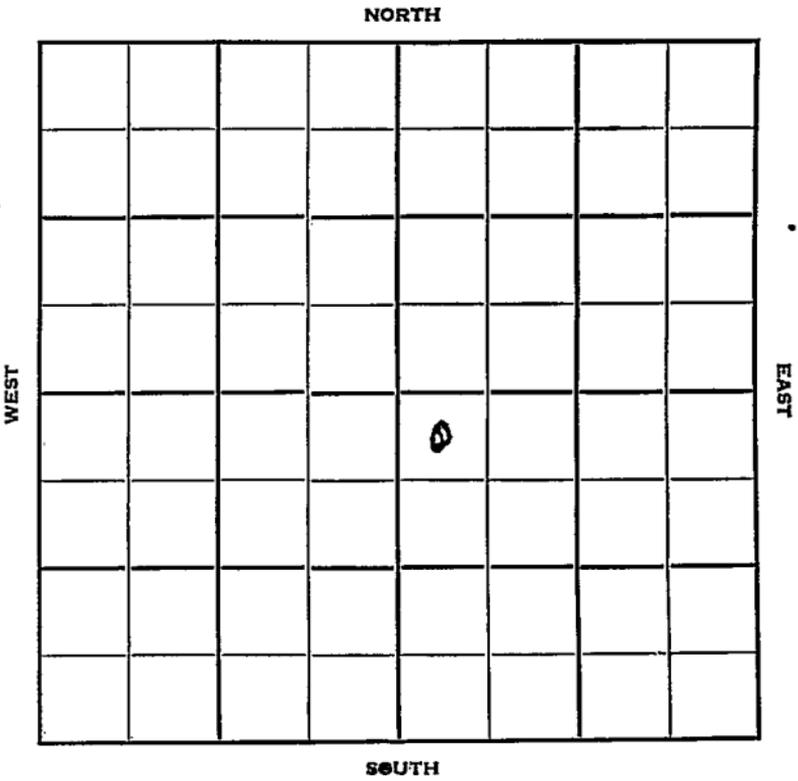

Rice

KANSAS

Sec. 11 Twp. 19 R. 10W

Well No. #11 Brandenstein Farm

Martin Wunderlich Company

Pickrell Drlg. Contractor

Chase Pool


330 Ft. from N. Line

\_\_\_\_\_ Ft. from S. Line

\_\_\_\_\_ Ft. from E. Line

330 Ft. from W. Line

NW NW SE

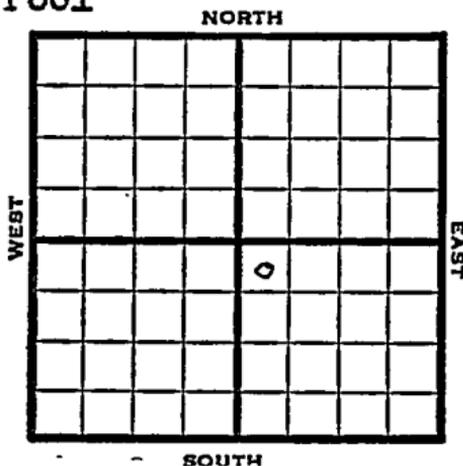

1952

Elev. 1711' REPORT

1/2 Spud 12-29-51  
13" @ 235'  
Drlg. 2823'

2/6 TD 3295'  
7" @ 3280' POP

2/13 No report

2/20 Spud 12-29-51  
Oil well TD 3311' 13" @ 235'  
Heeb 2789' Br. lime 2913'  
Lans. 2938' Cong. 3256'  
Ch. Cong. 3279'  
TD 3295' 7" @ 3280' DD 3311'  
19/3127-36 1000 A PB 3058'  
24/3021-30' S/4 1/2 BOPH  
Comp. 50 BOPD

COMPLETED



