


Section 11 Township 19 Range 10 W

Well No. # 7 Brandenstein

Company Martin Wunderlick

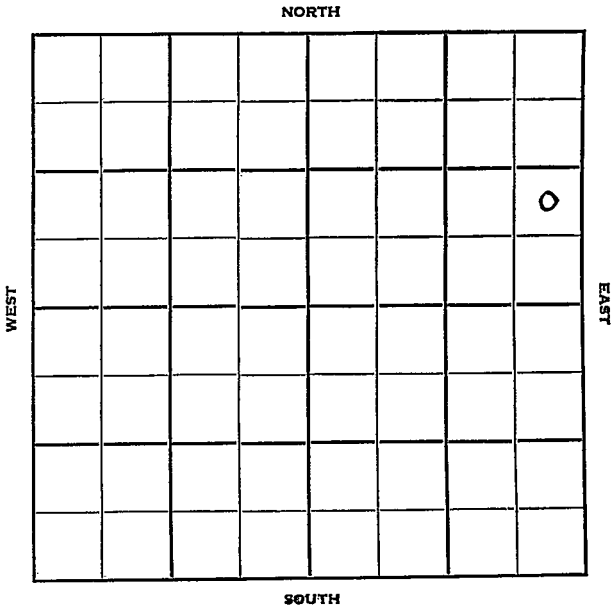

Rice KANSAS

Sec. 11 Twp. 19 R. 10 W.

Well No. # 7 Brandenstein Farm

Martin Wunderlick Company

Silica-Chase Pool


Ft. from N. Line

990 Ft. from S. Line

330 Ft. from E. Line

Ft. from W. Line

NE SE NE

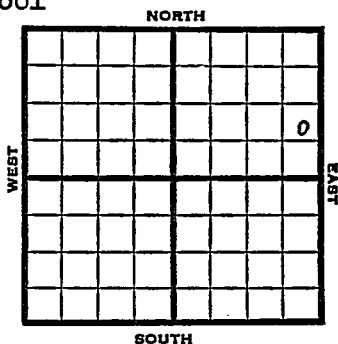

1951

Elev. 1724' REPORT

12/12

Cellar & Pits

1952
1/9

Spud 12-19-51
Oil Well TD 3135
8" @ 169
Heeb. 2760 Br lime 2886
Lans. 2912 5" @ 3135
TD 3135 48/3092-3100 wtr
PB 3080
24/3001-09 2000 A S/2 boph 6 bw
Comp. 50 bopd

COMPLETED

J. E. TYRA



Elev.	1724	Location	NE SE NE
-------	------	----------	----------

0

Spudding Date 12-19-51

Comp. 50% bopd

J. E. TYRA