


Section 11 Township 19 Range 10W

Well No. #1 Hoelscher

Company Pickrell Drilg.

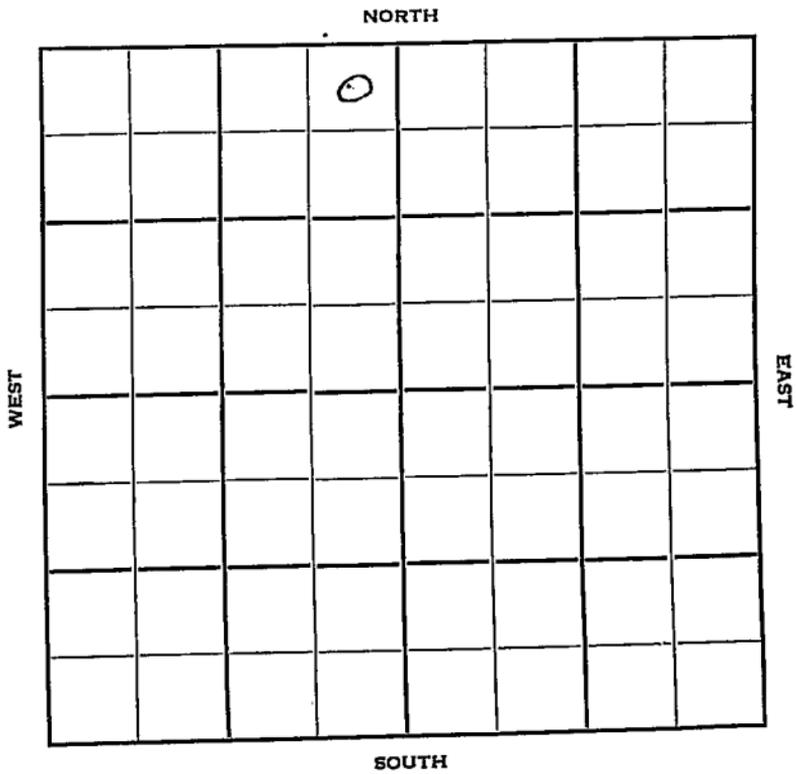

Rice

KANSAS

Sec. 11 Twp. - 19 R. 10W

Well No. #1 Hoelscher Farm

Pickrell Drlg. Company

Contractor

Silica Pool


330' Ft. from N. Line

Ft. from S. Line

330' Ft. from E. Line

Ft. from W. Line

NE NE W

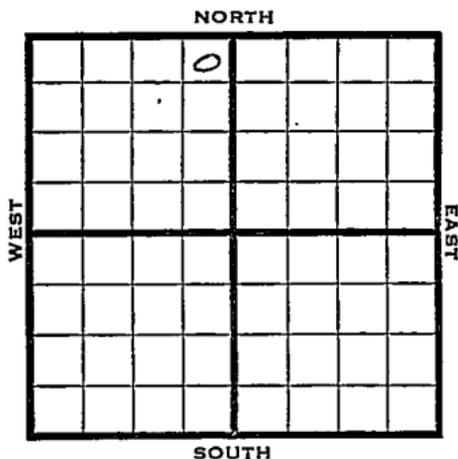

1950

Elev 1737'

REPORT

2/8

Spud 2-5-50
8" @ 192'

2/15

TD 3322'
8" @ 192'
Topeka 2531'
Heeb 2799'
Lans 2947'
Cong 3279'
D&A
Aband.

ABANDONED

Map No. _____ Sec. 11 Twp. 19 R. 10W

Well No. 1 Hoelscher

Pickrell Drlg. _____ Company

Contractor

NE NE NW


SECTION PLAT

330 _____ Ft. from N. Line

_____ Ft. from S. Line

330 _____ Ft. from E. Line

_____ Ft. from W. Line

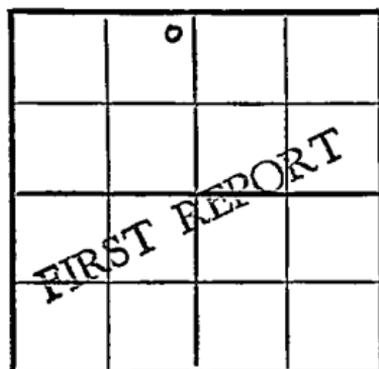

Rice County

RECORD

Location _____

Cased _____ in., _____ ft.

Rig up _____

Sand _____

Drilling and Remarks:

Gas _____

Spud 2-5-50

Oil _____

8" @ 192

Total Depth _____

PRODUCTION

1st 24 hrs. Nat. _____

1st 24 hrs. after shot _____

Gas _____ Cu. Ft.

Dry Hole _____

Abandoned _____

Date

FEB 8 1950
19

J. E. TYRA Scout

Map No. _____ Sec. ^{Kansas} 11 Twp. 19 R. 10W

Well No. 1 Hoelscher

Pickrell Drlg. _____ Company

_____ Contractor

NE NE NW


El. 1737
SECTION PLAT

330 Ft. from N. Line

_____ Ft. from S. Line

330 Ft. from E. Line

_____ Ft. from W. Line

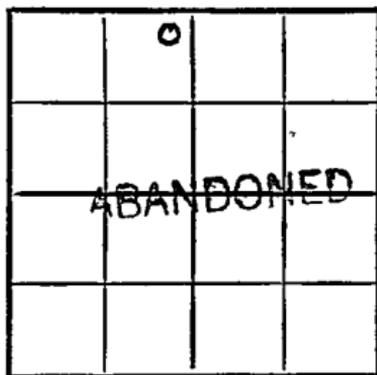

Rice County

Location _____

Rig up _____

Drilling and Remarks:

8" @ 192
Topokwa 2531
Kulb 2799
Lans 2947
Cong 3279
D & A.

RECORD

Cased _____ in., _____ ft.

Sand _____

Gas _____

Oil _____

Total Depth *3322*

PRODUCTION

1st 24 hrs. Nat. _____

1st 24 hrs. after shot _____

Gas _____ Cu. Ft.

Dry Hole _____

Abandoned _____

Date

FEB 15 1950

J. E. TYRA

19

Scout