



Sec. 11 Twp. KANSAS R. 19 10W

Well No. #1 Schmidt Farm

Holl & Branine

Company


Silica Pool

990' Ft. from N. Line

 Ft. from S. Line

330' Ft. from E. Line

 Ft. from W. Line

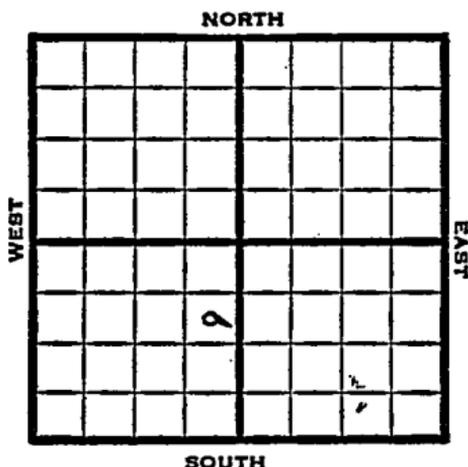

SE NE SW

1949

^Elev 1747'

REPORT

4/20

8" @ 250'

Drlg. 1670'

4/27

Lansing 2941'

Cong 3277-83'

TD 3283'

5" @ 3277'

5/4

"

5/11

TD 3283'

Cong 3277'

5" @ 3277'

Pump 50 oil Pot

42° Gr.

Comp^g

COMPLETED

Map No. _____ Sec. 11 Twp. 19 R. 10W

Well No. 1 Schmidt

Holl & Branine Company

FIRST REPORT

Contractor

SE NE SW


SECTION PLAT

990 Ft. from N. Line

_____ Ft. from S. Line

330 Ft. from E. Line

_____ Ft. from W. Line

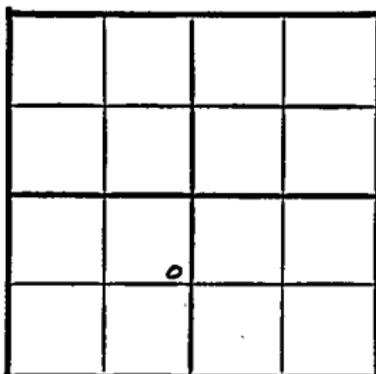

Rice County

Location _____

Rig up _____

Drilling and Remarks:

8" @ 250
drlg. 1670

RECORD

Cased _____ in., _____ ft.

Sand _____

Gas _____

Oil _____

Total Depth _____

PRODUCTION

1st 24 hrs. Nat. _____

1st 24 hrs. after shot _____

Gas _____ Cu. Ft.

Dry Hole _____

Abandoned _____

Date

APR 20 1949 19

S. I. LEWIS Scout

Map No. 246 Sec. 11 Twp. 19 R. 10W

Well No. 1 Schmidt

Holl & Branine Company

COMPLETE

Contractor

SE NE SW

E 1747

SECTION PLAT

990 Ft. from N. Line

 Ft. from S. Line

330 Ft. from E. Line

 Ft. from W. Line

	1	2-7	

Rice County

Location

Rig up

Drilling and Remarks:

*Comp 9277
5" @ 9277*

Prod 50 oil per

42 3/4

RECORD

Cased in., ft.

Sand

Gas

Oil

Total Depth 3283

PRODUCTION

1st 24 hrs. Nat.

1st 24 hrs. after shot

Gas Cu. Ft.

Dry Hole

Abandoned

Date

MAY 11 1949 19

S. J. LEWIS Scout