

Form 267-161-Exs. 9-28
W. J. Johnson

KANSAS

Map No. *K43* Sec. *11* Twp. *19* R. *2W*


Well No. *4 - Fleming*

Shell pet Company

Contractor

FIRST REPORTS

SECTION PLAT

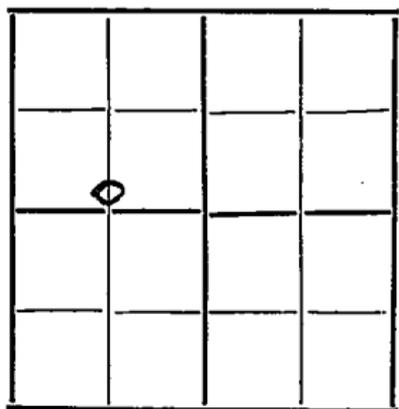

Ft. from N. Line

330

Ft. from S. Line

1332

Ft. from E. Line

Ft. from W. Line

Location.....

Rig up.....

Drilling and Remarks:

Moving

RECORD

Cased.....in.,ft.

Sand.....

Gas.....

Oil.....

Total Depth.....

PRODUCTION

1st 24 hrs. Nat.....

1st 24 hrs. after shot.....

Gas.....Cu. Ft.

Dry Hole.....

Abandoned.....

Date

ORVAL MANSCHRECK

5-28-35 192

Scout

Map No. 43 Sec. 11 Twp. 19 R. 2W


Well No. 4 - Fleming

Shell Petroleum Company

Contractor

~~COMPLETED~~

SECTION PLAT

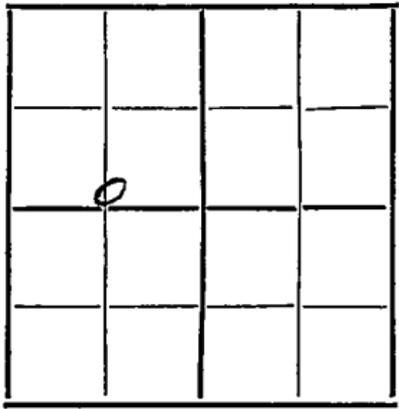

..... Ft. from N. Line

330 Ft. from S. Line

1337 Ft. from E. Line

..... Ft. from W. Line

Location.....

Rig up.....

Drilling and Remarks:

428 lbs

RECORD

Cased..... in., ft.

Sand Viola 3383

Gas.....

Oil.....

Total Depth 3392

PRODUCTION

1st 24 hrs. Nat.....

1st 24 hrs. after shot.....

Gas..... Cu. Ft.

Dry Hole.....

Abandoned.....

Date

7-31-35 192.....

IRVAL MANSCHRECK

Scout