

McPherson

Form 252-A
5M 4-32 MPC

KANSAS

Map No. _____ Sec. 11 Twp. 19 R. 2W

Well No. 3 - Fleming Farm


McPherson O. & G. - Shell Company

660 Ft. from N. Line

_____ Ft. from S. Line

660 Ft. from E. Line

_____ Ft. from W. Line

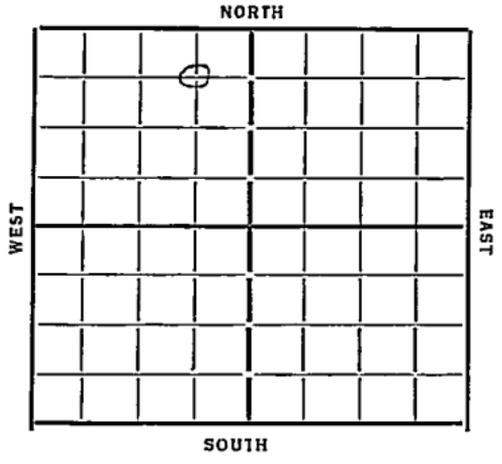

Date
1933

REPORT

7/12 location

7/19 13" - 106 W.O.D.

7/26 July 1907'

8/2 Top Chat 2923 T.D. 2925 Cement 8"

8/19 R, U, S, T,

8/17 2926 - 2 mil gas T.D. 2948 - 9M gas 300 oil
cut

8/23 Chat 2921-2948 T.D.,
9M gas 300 oil

COMPLETED

Mepheron
 Map No. _____ Sec. 11 Twp. 19 R. 2W

43-3 Well No. Fleming

Mepheron Oil & Shell Company

Contractor

SECTION PLAT

	0		

660 Ft. from N. Line

_____ Ft. from S. Line

660 Ft. from E. Line

_____ Ft. from W. Line

FIRST REPORTS

Location

Rig up _____

Drilling and Remarks:

RECORD

Cased _____ in., _____ ft.

Sand _____

Gas _____

Oil _____

Total Depth _____

PRODUCTION

1st 24 hrs. Nat. _____

1st 24 hrs. after shot _____

Gas _____ Cu. Ft.

Dry Hole _____

Abandoned _____

Date

7/12/33 192

Oral Wamschech
 Scout

Map No. 43 Sec. 11 Twp. 19 R. 2W

Well No. 3 Op. Leming

Mephuson Oil & Shell Company

Contractor

SECTION PLAT

660 Ft. from N. Line

..... Ft. from S. Line

660 Ft. from E. Line

..... Ft. from W. Line

	0		

COMPLETED

Location.....

Rig up.....

Drilling and Remarks:

RECORD

Cased..... in., ft.

Sand Chat 2921

Gas.....

Oil.....

Total Depth 2948

PRODUCTION

1st 24 hrs. Nat.....

1st 24 hrs. after shot.....

Gas..... Cu. Ft.

Dry Hole.....

Abandoned.....

Date

8/23/32 O. Manschreck Scout

9 m gas
300 out